


North

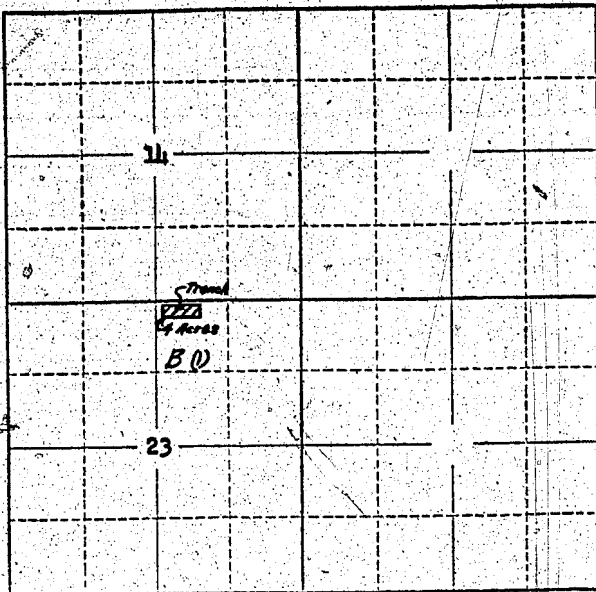

Locate well and acreage of irrigated land on plat
Scale: 2" = 1 Mile

STATE OF OREGON

County of Jackson } ss.

I, Anna G. Brewer, being first duly sworn, do hereby certify that I have read the foregoing Registration Statement and that all of the items therein contained are true to the best of my knowledge and belief.

Anna G. Brewer
(Signature of Registrant)

Subscribed and sworn to before me this 13th day of March, 1956

My commission expires October 7, 1957

John Dow
(Notary Public)

(SEAL)

CERTIFICATE OF REGISTRATION

STATE OF OREGON } ss.
County of Marion

This is to certify that the foregoing Registration Statement was received in the office of the State Engineer on the 30th day of March, 1956, at 10:30 o'clock A. M. and has been duly recorded in said office in Book No. 1 of Registration Statements on page GR-111 C.

~~Certificate shall be completed by _____ and the return completed applicant to _____~~

~~_____ by _____~~

Witness my hand this 8th day of October, 1956

Lewis A. Stanley
(State Engineer)

By _____ (Deputy)