


ACMPC Oregon 2, LLC
Halls Ferry Farms
Groundwater Registration Modification - GR 1515

RECEIVED

NOV 18 2020

OWRD

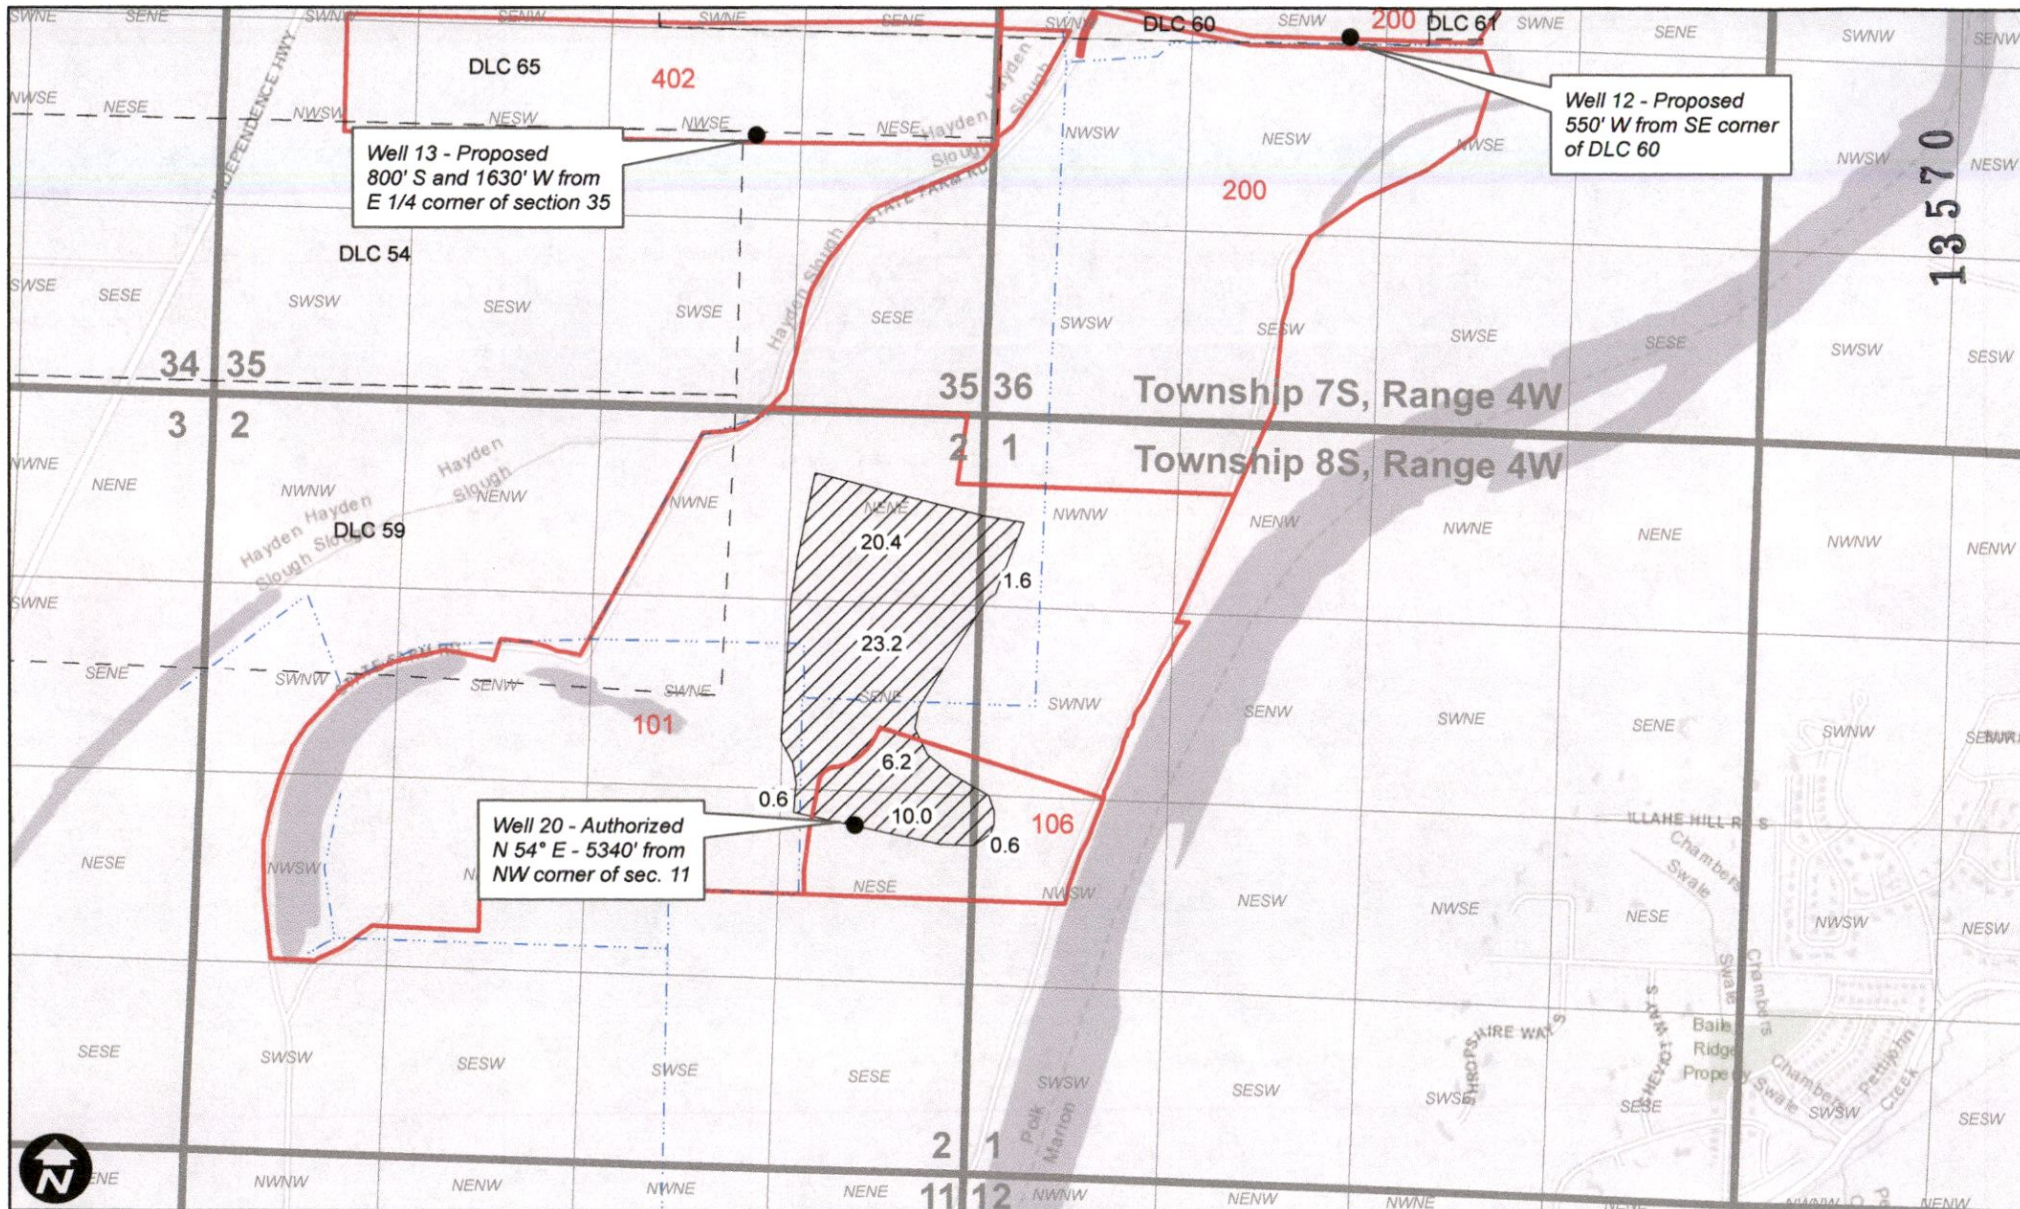


Legend

GR 1515 APOA
 Irrigation Mainline
 Tax Lot
 DLC



Township 8 S Range 4 W W.M.
North

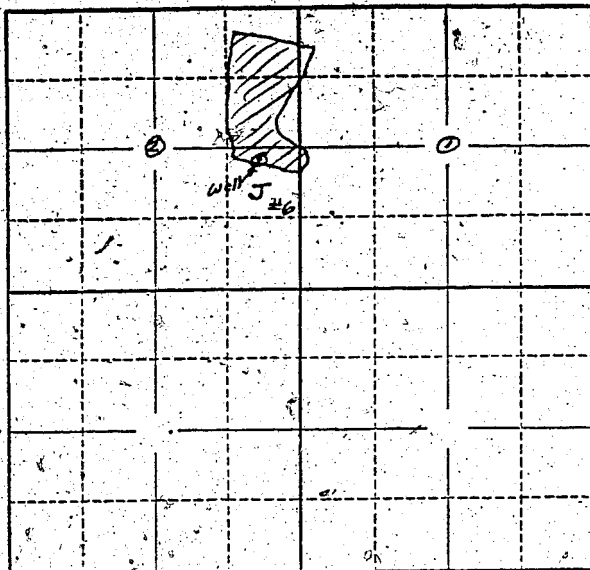

Locate well and acreage of irrigated land on plat.

Scale: 2" = 1 Mile

STATE OF OREGON

County of Marion

I, ECLENS FOREST being first duly sworn, do hereby certify that I have read the foregoing Registration Statement and that all of the items therein contained are true to the best of my knowledge and belief.

(Signature of Registrant)

Subscribed and sworn to before me this 25th day of March, 19 58

My commission expires 12th June 1961

Wm. S. Bartholomew
(Notary Public)

(SEAL)

CERTIFICATE OF REGISTRATION

STATE OF OREGON

County of Marion

This is to certify that the foregoing Registration Statement was received in the office of the State Engineer on the 25th day of April, 19 58, at 9:30 o'clock A M. and has been duly recorded in said office in Book No. 7 of Registration Statements on page GR-1463

Witness my hand this 1st day of December, 19 58

Lewis A. Stanley
(State Engineer)

By

(Deputy)

GR - 1463