


North

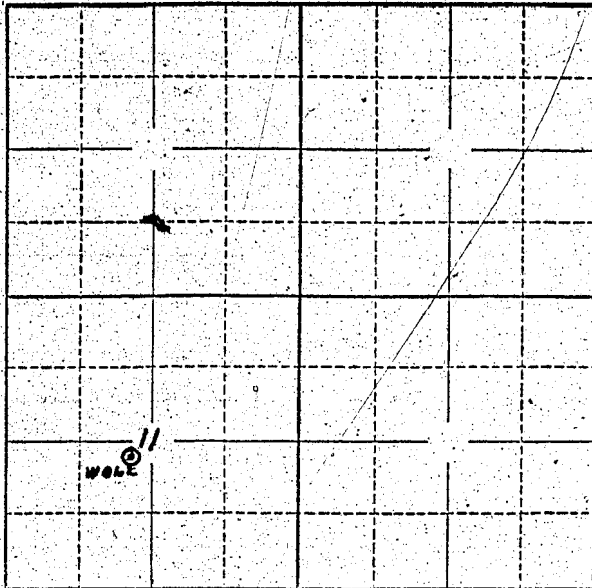

Locate well and acreage of irrigated land on plat.

Scale: 2" = 1 Mile

STATE OF OREGON

County of Marion } ss.

I, A. W. Metzger, being first duly sworn, do hereby certify that I have read the foregoing Registration Statement and that all of the items therein contained are true to the best of my knowledge and belief.

X [Signature of Registrant]

(Signature of Registrant)

Subscribed and sworn to before me this 6th day of April, 1956.

My commission expires Oct. 16, 1959

[Signature of Notary Public]

(Notary Public)

(SEAL)

CERTIFICATE OF REGISTRATION

STATE OF OREGON

County of Marion } ss.

This is to certify that the foregoing Registration Statement was received in the office of the State Engineer on the 30th day of March, 1956, at 3:30 o'clock P.M. and has been duly recorded in said office in Book No. 1 of Registration Statements on page GR-115 C.

Construction work completed by [redacted] and the water completely completed to beneficial use by [redacted].

Witness my hand this 8th day of October, 1956

[Signature of State Engineer]

(State Engineer)

By [redacted] (Deputy)