


Township 15 Range 2 W, W.M.
North

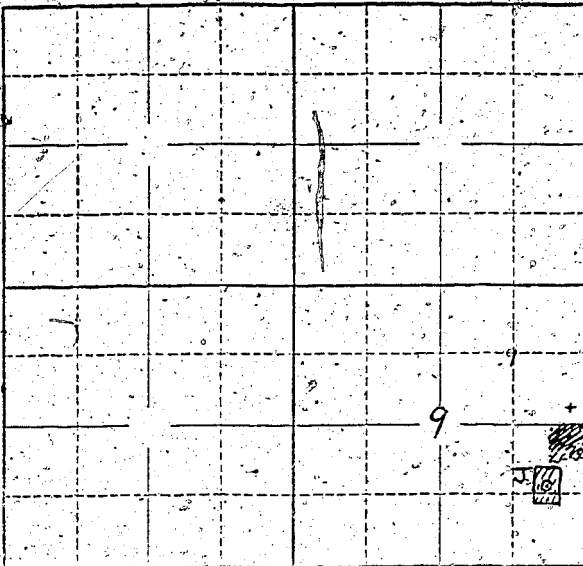

Locate well and acreage of irrigated land on plat.

Scale: 2" = 1 Mile

STATE OF OREGON

County of Washington ss.

I, Ralph Raediger, being first duly sworn, do hereby certify that I have read the foregoing Registration Statement and that all of the items therein contained are true to the best of my knowledge and belief.

Ralph Raediger
(Signature of Registrant)

Subscribed and sworn to before me this 28 day of April, 1955.

My commission expires _____

NOTARY PUBLIC FOR OREGON

(Notary Public)

(SEAL) My Commission Expires Feb. 18, 1962

CERTIFICATE OF REGISTRATION

STATE OF OREGON

County of Marion } ss.

This is to certify that the foregoing Registration Statement was received in the office of the State Engineer on the 29th day of April, 1955 at 5 o'clock P. M. and has been duly recorded in said office in Book No. 7 of Registration Statements on page GR-1530

~~Construction shall be completed by _____ and the water completely applied or beneficial use by _____~~

Witness my hand this 1st day of December, 1955.

[Signature]
(State Engineer)

By _____ (Deputy)

\$15.00

GR-1530