


Township 16 S Range 4 W, W.M.

Sec 9 North Sec 10

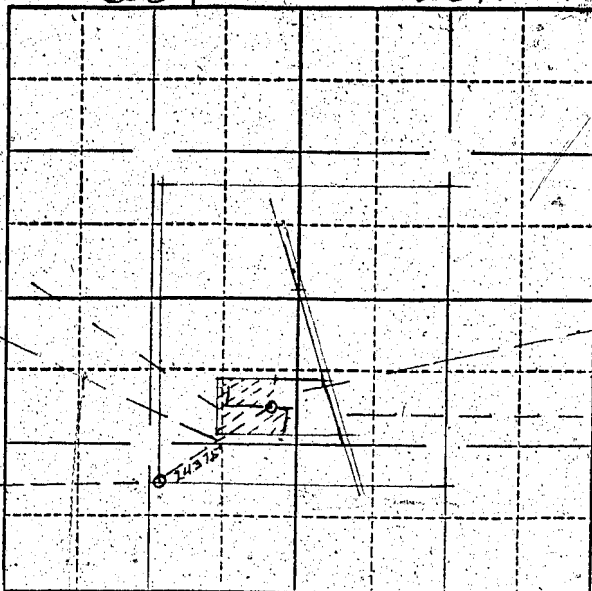

Pipe Line

Well is $75^{\circ}30'E$
2437.5 from SW
Cn Wm Buier D.L.C.

40 ft. tract to
be irrigated

River Road

SW Cn Wm Buier
D.L.C #50 marked
by Stone Top above ground

Locate well and acreage of irrigated land on plat.

Scale: 2" = 1 Mile

STATE OF OREGON

County of Lane

ss.

I, William Harper & Madge E. Harper, being first duly sworn, do hereby certify that I have read the foregoing Registration Statement and that all of the items therein contained are true to the best of my knowledge and belief.

Subscribed and sworn to before me this 28th day of March, 1956

My commission expires April 11, 1956

Leona Stuckert
(Notary Public)

(SEAL)

CERTIFICATE OF REGISTRATION

STATE OF OREGON

County of Marion

ss.

This is to certify that the foregoing Registration Statement was received in the office of the State Engineer on the 30th day of March, 1956, at 3:30 o'clock P.M. and has been duly recorded in said office in Book No. 1 of Registration Statements on page GR-116 H

~~Construction shall be completed by 1956 and the water completely applied in beneficial use by 1956~~

Witness my hand this 8th day of October, 1956

Lewis A. Stanley
(State Engineer)

By _____
(Deputy)

GR-146 H