


Township 55 Range 3W W.M.

North

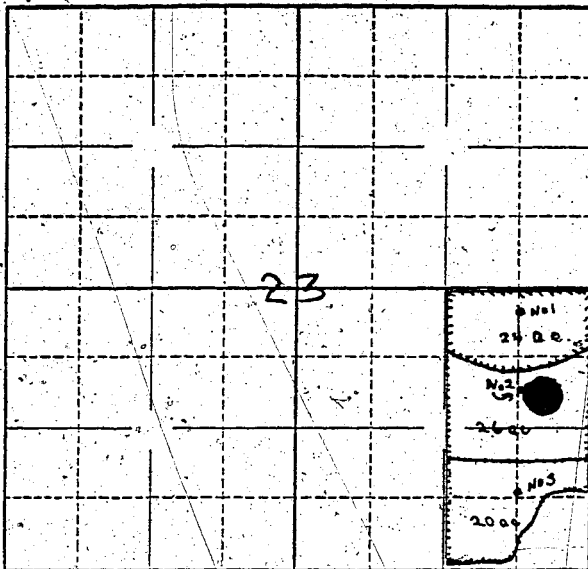

Locate well and acreage of irrigated land on plat.

Scale: ~~1/4~~ - 1 Mile

STATE OF OREGON

County of Yamhill } ss.

I, Harvey Ewert, being first duly sworn, do hereby certify that I have read the foregoing Registration Statement and that all of the items therein contained are true to the best of my knowledge and belief.

Harvey Ewert
(Signature of Registrant)

Subscribed and sworn to before me this 8th day of April, 19 58

My commission expires

Anna M. Gargis
(Notary Public)

(SEAL)

CERTIFICATE OF REGISTRATION

STATE OF OREGON

County of Marion } ss.

This is to certify that the foregoing Registration Statement was received in the office of the State Engineer on the 2nd day of May, 1958, at 8:00 o'clock A. M. and has been duly recorded in said office in Book No. 7 of Registration Statements on page 6E-1484

Witness my hand this 1st day of December, 1958

Lewis A. Stenley
(State Engineer)

By

(Deputy)

GR - 1484

1500