


North

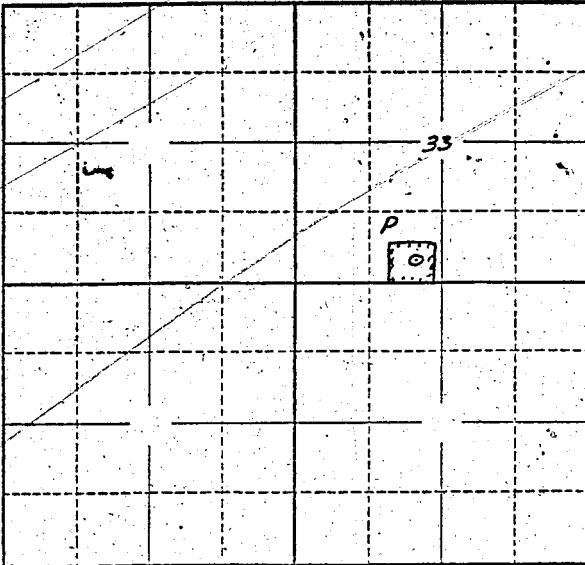

Locate well and acreage of irrigated land on plat.

Scale: 2" = 1 Mile

STATE OF OREGON

County of Lane } ss.

I, HERMAN KANKER, being first duly sworn, do hereby certify that I have read the foregoing Registration Statement and that all of the items therein contained are true to the best of my knowledge and belief.

Herman Kanker
(Signature of Registrant)

Subscribed and sworn to before me this 14th day of March, 1958

My commission expires June 25, 1961
Lulla A. Hanson
(Notary Public)

(SEAL)

CERTIFICATE OF REGISTRATION

STATE OF OREGON

County of Marion } ss.

This is to certify that the foregoing Registration Statement was received in the office of the State Engineer on the 6th day of May, 1958, at 10:00 o'clock A.M. and has been duly recorded in said office in Book No. 7 of Registration Statements on page GR-1492

Witness my hand this 1st day of December, 1958
Lulla A. Hanson
(State Engineer)

By _____ (Deputy)