


Township 25 Range 1W, W.M.

North

2576 E → N.E. Cor. Sec. #11

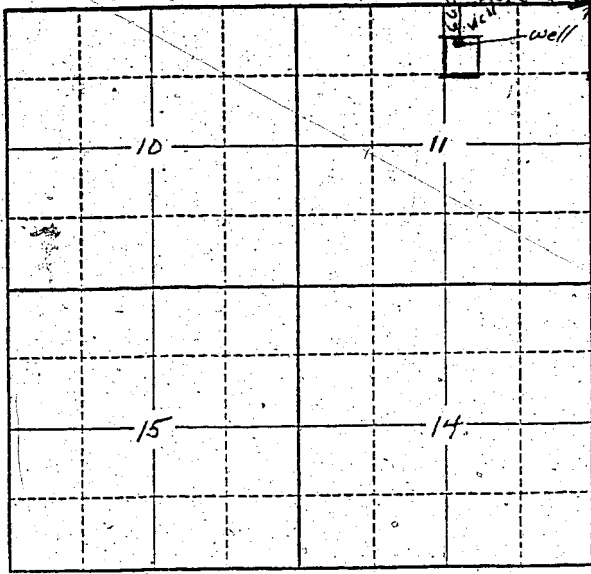

Locate well and acreage of irrigated land on plat.
Scale: 2" = 1 Mile

STATE OF OREGON

County of Washington

EMPIRE OF IRAN
DISTRICT AND CITY OF TEHRAN
EMBASSY OF THE UNITED STATES } ss:
OF AMERICA

I, George L. Rowan, being first duly sworn, do hereby certify that I have read the foregoing Registration Statement and that all of the items therein contained are true to the best of my knowledge and belief.

George L. Rowan
(Signature of Registrant)

Subscribed and sworn to before me this 11th day of February, 1958.

My commission expires

John C. Thornburg
(Notary Public)

(SEAL)

John C. Thornburg
Consul of the United States of America
at Tehran, Iran

CERTIFICATE OF REGISTRATION

Service No. 644
Tariff Item No. 45
Fee Paid US\$ 2.50
Fees in Equip. 200 Fla

STATE OF OREGON

County of Marion

} ss.

This is to certify that the foregoing Registration Statement was received in the office of the State Engineer on the 7th day of May, 1958, at 1:00 o'clock P. M. and has been duly recorded in said office in Book No. 7 of Registration Statements on page GR-1499

Witness my hand this 1st day of December, 1958

Lewis J. Stanley
(State Engineer)

By _____
(Deputy)