


North

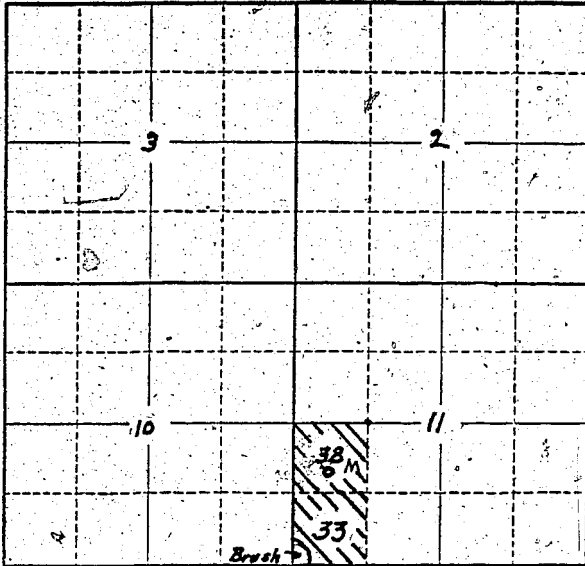

Locate well and acreage of irrigated land on plat.

Scale: 2" = 1 Mile

STATE OF OREGON

County of Marion } ss.

I, Nels Sanden, being first duly sworn, do hereby certify that I have read the foregoing Registration Statement and that all of the items therein contained are true to the best of my knowledge and belief.

Nels Sanden
(Signature of Registrant)

Subscribed and sworn to before me this 20th day of February, 1958.

My commission expires Sept. 8, 1960

Chas. J. Miller
(Notary Public)

(SEAL)

CERTIFICATE OF REGISTRATION

STATE OF OREGON }
County of Marion } ss.

This is to certify that the foregoing Registration Statement was received in the office of the State Engineer on the 12th day of May, 1958, at 8:00 o'clock A.M. and has been duly recorded in said office in Book No. 7 of Registration Statements on page GR 1503

Witness my hand this 1st day of December, 1958.

Lewis A. Attala
(State Engineer)

\$ 21.15

By _____ (Deputy)