


North

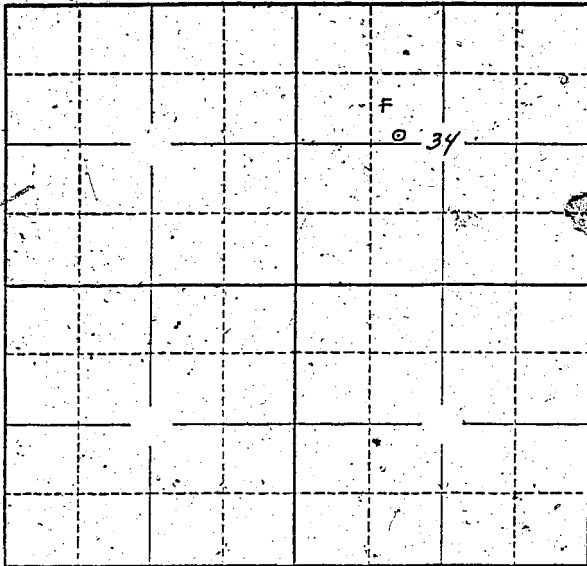

Locate well and acreage of irrigated land on plat.

Scale: 2" = 1 Mile

STATE OF OREGON

County of LINN } ss.

I, Ammon Bros., being first duly sworn, do hereby certify that I have read the foregoing Registration Statement and that all of the items therein contained are true to the best of my knowledge and belief.

Ammon Bros
E. J. Ammon
(Signature of Registrant)

Subscribed and sworn to before me this 13th day of May, 1958

MY COMMISSION EXPIRES APR. 14, 1960

My commission expires: _____

Jeff Caushe
(Notary Public)

(SEAL)

CERTIFICATE OF REGISTRATION

STATE OF OREGON } ss.
County of Marion

This is to certify that the foregoing Registration Statement was received in the office of the State Engineer on the 19th day of May, 1958, at 6:00 o'clock A.M. and has been duly recorded in said office in Book No. 7 of Registration Statements on page GR-1517

Witness my hand this 1st day of December, 1958

Paul W. A. [Signature]
(State Engineer)

By _____ (Deputy)

#1515