


North

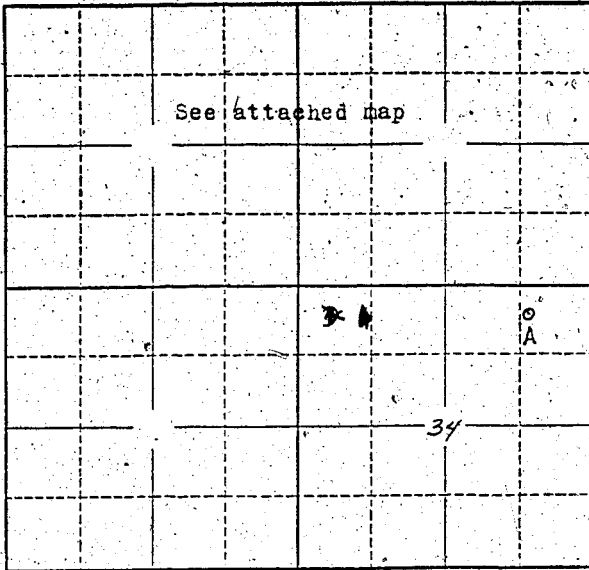

Locate well and acreage of irrigated land on plat.

Scale: 2" = 1 Mile

STATE OF OREGON

County of MULTNOMAH

ss.

I, PAUL G. SHERMAN, being first duly sworn, do hereby certify that I have read the foregoing Registration Statement and that all of the items therein contained are true to the best of my knowledge and belief.

Paul G. Sherman
(Signature of Registrant) Mayor
City of Wood Village

Subscribed and sworn to before me this 15th day of May, 1958.

My commission expires _____
William E. Eckhart
(Notary Public)

(SEAL)

CERTIFICATE OF REGISTRATION

STATE OF OREGON

County of Marion

ss.

This is to certify that the foregoing Registration Statement was received in the office of the State Engineer on the 20th day of May, 1958, at 8:00 o'clock A.M. and has been duly recorded in said office in Book No. 7 of Registration Statements on page GR-1537

Witness my hand this 1st day of December, 1958.
Edwin A. Atkinson
(State Engineer)

By _____ (Deputy)

\$20.00