


Township 6N Range 35E, W.M.
North

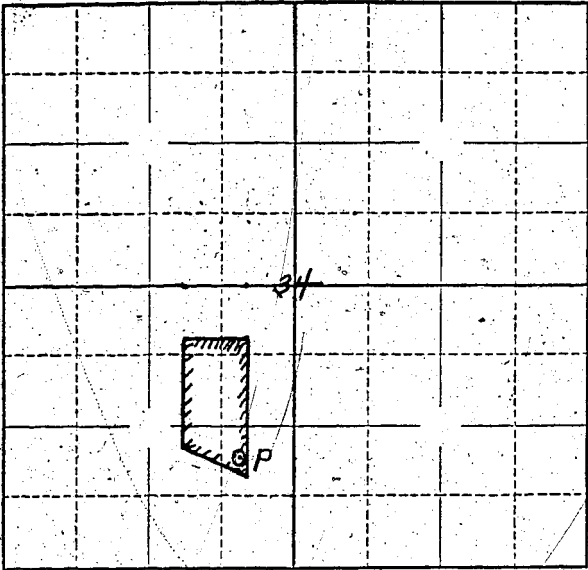

Locate well and acreage of irrigated land on plat.
Scale: 4 -- 1 Mile

STATE OF OREGON }

I, _____ being first duly sworn, do hereby certify that I have read the foregoing Registration Statement and that all of the items therein contained are true to the best of my knowledge and belief.

(Signature of Registrant)

Subscribed and sworn to before me this _____ day of _____, 19____

My commission expires _____ (Notary Public)

(SEAL)

CERTIFICATE OF REGISTRATION

STATE OF OREGON }
County of Marion } ss.

This is to certify that the foregoing Registration Statement was received in the office of the State Engineer on the 22nd day of May, 1958, at 6:55 o'clock A. M. and has been duly recorded in said office in Book No. 7 of Registration Statements on page OR-1550

Witness my hand this 1st day of December, 1958
Leona B. Standa
(State Engineer)

By _____ (Deputy)

GR - 1550

\$15.00