


Township 9 S Range 2 W W.M. North

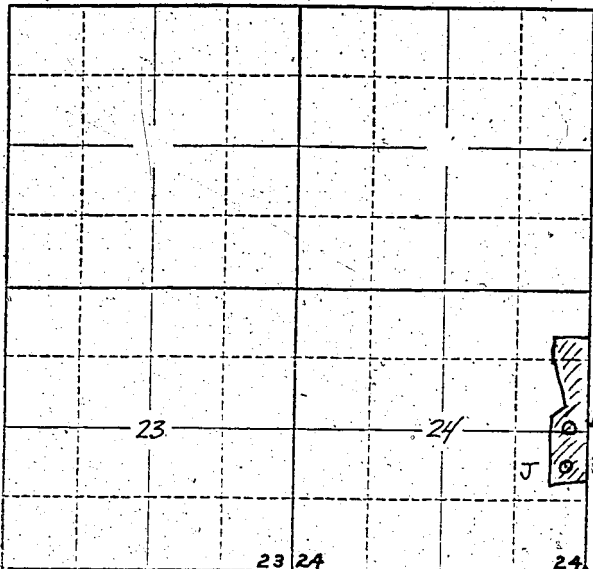

Locate well and acreage of irrigated land on plat. Scale: 2" = 1 Mile

STATE OF OREGON

County of Marion ss.

I, Howard H. Ralph, being first duly sworn, do hereby certify that I have read the foregoing Registration Statement and that all of the items therein contained are true to the best of my knowledge and belief.

Howard H. Ralph (Signature of Registrant)

Subscribed and sworn to before me this 23rd day of May, 1958.

My commission expires 12th June 1961

Wm. S. Bartholomew (Notary Public)

(SEAL)

CERTIFICATE OF REGISTRATION

STATE OF OREGON

County of Marion ss.

This is to certify that the foregoing Registration Statement was received in the office of the State Engineer on the 23rd day of May, 1958, at 11:00 o'clock A.M. and has been duly recorded in said office in Book No. 7 of Registration Statements on page GR-1556


~~Construction shall be completed by 10/1/59 and the water completely applied to the fields by 10/1/59~~

Witness my hand this 1st day of December, 1958

(State Engineer)

By (Deputy)

GR-1556

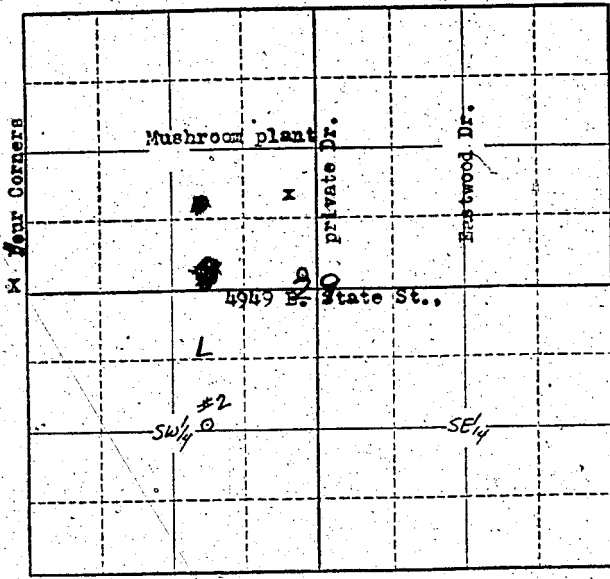

Locate well and acreage of irrigated land on plat.

Scale: 4" = 1 Mile
 4" = 1 mile

STATE OF OREGON

County of Marion

I, Howard R. West, being first duly sworn, do hereby certify that I have read the foregoing Registration Statement and that all of the items therein contained are true to the best of my knowledge and belief.

West Foods, Inc.

(Signature of Registrant)

sec'y

Subscribed and sworn to before me this 17th day of November, 1958

My commission expires August 13, 1961

Lenta Howe
 (Notary Public)

(SEAL)

CERTIFICATE OF REGISTRATION

STATE OF OREGON

County of Marion

ss.

This is to certify that the foregoing Registration Statement was received in the office of the State Engineer on the 21st day of May, 1957, at 8:00 o'clock A.M. and has been duly recorded in said office in Book No. 57 of Registration Statements on page GR-1566 G

Witness my hand this 1st day of December, 1958

Laura G. Stanley
 (State Engineer)

By _____ (Deputy)

\$ 20.00