


North

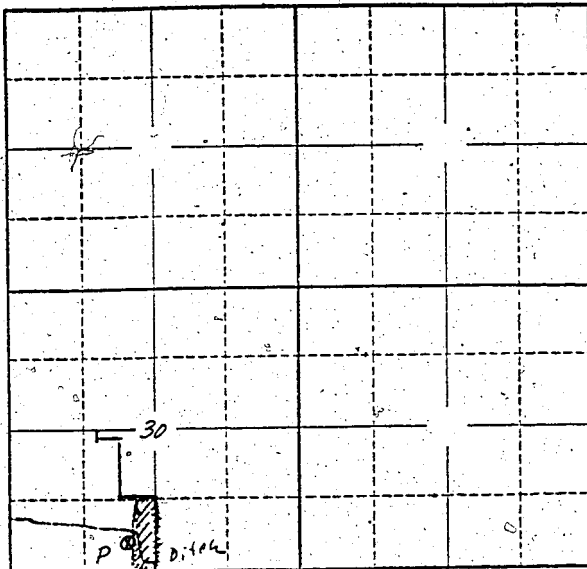

Sec 30

Locate well and acreage of irrigated land on plat.

Scale: 2" = 1 Mile

STATE OF OREGON

County of JACKSON } ss.

I, CLYDE GREENSHAW, being first duly sworn, do hereby certify that I have read the foregoing Registration Statement and that all of the items therein contained are true to the best of my knowledge and belief.

Clyde Greenshaw
(Signature of Registrant)

Subscribed and sworn to before me this 23 day of MAY, 19 56.

My commission expires Sept. 10, 1961

D. J. Miller
(Notary Public)

(SEAL)

CERTIFICATE OF REGISTRATION

STATE OF OREGON

County of Marion } ss.

This is to certify that the foregoing Registration Statement was received in the office of the State Engineer on the 26th day of May, 1956, at 8:00 o'clock A. M. and has been duly recorded in said office in Book No. 7 of Registration Statements on page GR-1561

Witness my hand this 1st day of December, 1958

Lewis A. Stankley
(State Engineer)

By _____ (Deputy)

#1500