


Township 75 Range 3W, W.M.
North

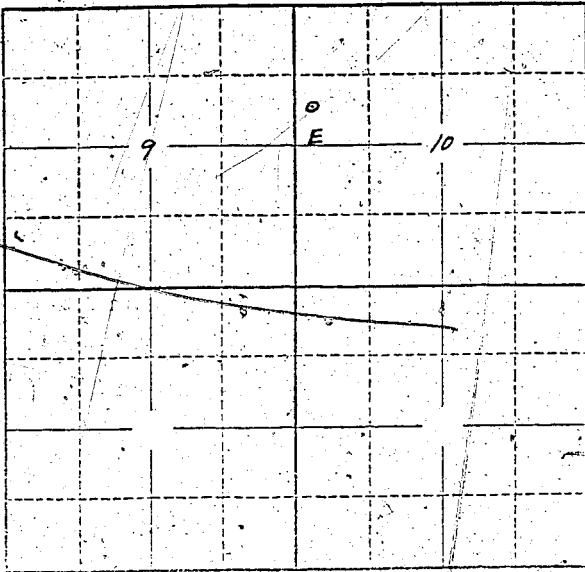

Locate well and acreage of irrigated land on plat.
Scale: 2" = 1 Mile

STATE OF OREGON

County of Marion ss.

I, Margaret Tschauner Loucks, being first duly sworn, do hereby certify that I have read the foregoing Registration Statement and that all of the items therein contained are true to the best of my knowledge and belief.

Margaret Tschauner Loucks
(Signature of Registrant)

Subscribed and sworn to before me this 26th day of May, 1958.

My commission expires 12th June 1961

Wm. S. Bartholomew
(Notary Public)

(SEAL)

CERTIFICATE OF REGISTRATION

STATE OF OREGON }
County of Marion } ss.

This is to certify that the foregoing Registration Statement was received in the office of the State Engineer on the 26th day of May, 1958, at 12⁰⁰ o'clock A. M. and has been duly recorded in said office in Book No. 7 of Registration Statements on page GR-1562

Witness my hand this 1st day of December, 1958

Lewis A. Bittner
(State Engineer)

\$15.00

By _____ (Deputy)

GR-1562