


S $\frac{1}{2}$ Section 23 & N $\frac{1}{4}$ section 26

Township 4S Range 1W W.M.

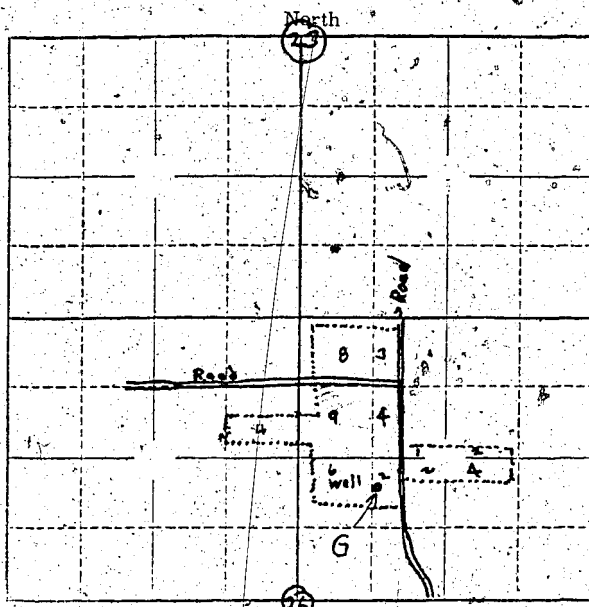

Locate well and acreage of irrigated land on plat.

Scale: 1" = 1 Mile

STATE OF OREGON

County of CLACKAMAS

I, ED BUREAU, being first duly sworn, do hereby certify that I have read the foregoing Registration Statement and that all of the items therein contained are true to the best of my knowledge and belief.

Ed Bureau
(Signature of Registrant)

Subscribed and sworn to before me this 17th day of April, 1958

My commission expires December 7th, 1961

(Notary Public)

(SEAL)

CERTIFICATE OF REGISTRATION

STATE OF OREGON }
County of Marion } ss.

This is to certify that the foregoing Registration Statement was received in the office of the State Engineer on the 27 day of May, 1958, at 800 o'clock A.M. and has been duly recorded in said office in Book No. 7 of Registration Statements on page GR-1571

~~Construction shall be completed by 1958 and the water completely applied to beneficial use by 1958.~~

Witness my hand this 1st day of December, 1958

(State Engineer)

By

(Deputy)

GR-1571