


North

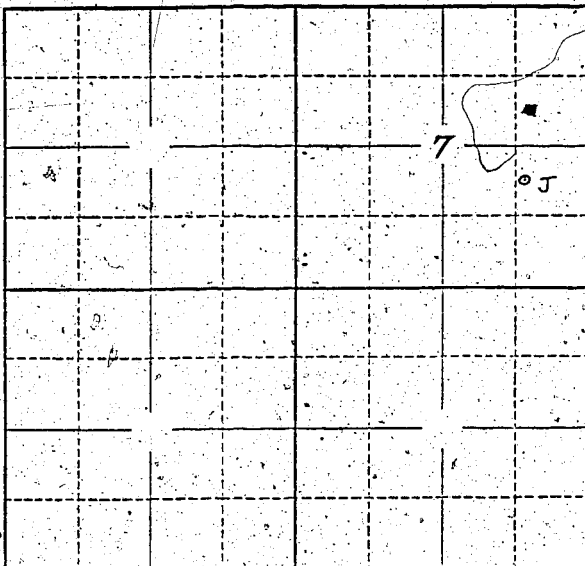

Locate well and acreage of irrigated land on plat.

Scale: 2" = 1 Mile

STATE OF OREGON

County of Lane } ss.

By Mr. Clarence L. and Edna M. Briggs, being first duly sworn, do hereby certify that I have read the foregoing Registration Statement and that all of the items therein contained are true to the best of my knowledge and belief.

*Clarence L. Briggs*  
*Edna M. Briggs*  
(Signature of Registrant)

Subscribed and sworn to before me this 22d day of May, 1958

My commission expires Dec. 15, 1961.  
*Virginia M. Harris*  
(Notary Public)

(SEAL)

**CERTIFICATE OF REGISTRATION**

STATE OF OREGON

County of Marion } ss.

This is to certify that the foregoing Registration Statement was received in the office of the State Engineer on the 26th day of May, 1958, at 5:00 o'clock PM and has been duly recorded in said office in Book No. 7 of Registration Statements on page GR-1577

Witness my hand this 1st day of December, 1958

*Lewis A. Stanley*  
(State Engineer)

By \_\_\_\_\_ (Deputy)