


Township 6 S Range 3 W W.M.
North

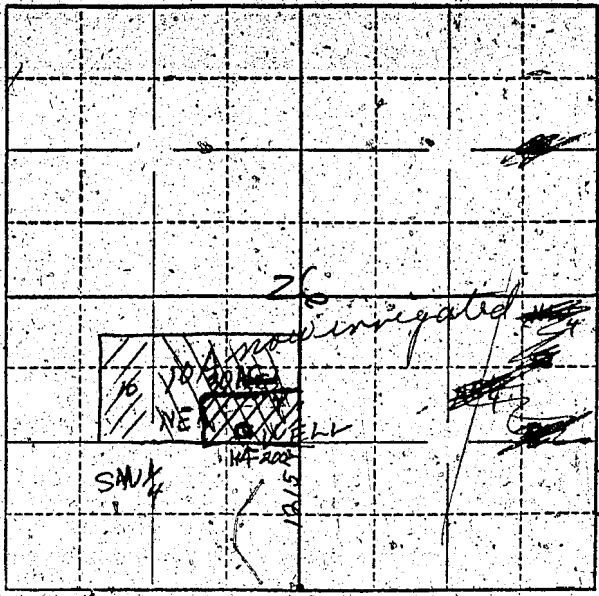

Locate well and acreage of irrigated land on plat.
Scale: 4" = 1 Mile

STATE OF OREGON
County of Marion } ss.

I, DETE TARANOFF, being first duly sworn, do hereby certify that I have read the foregoing Registration Statement and that all of the items therein contained are true to the best of my knowledge and belief.

x Det. Taranoff
(Signature of Registrant)

Subscribed and sworn to before me this 23rd day of April, 1956

My commission expires Dec 8, 1957
Clarence A. [Signature]
(Notary Public)

(SEAL)

CERTIFICATE OF REGISTRATION

STATE OF OREGON } ss.
County of Marion

This is to certify that the foregoing Registration Statement was received in the office of the State Engineer on the 23rd day of April, 1956, at 3:10 o'clock P.M. and has been duly recorded in said office in Book No. 1 of Registration Statements on page GR-155-C.
Construction shall be completed by October 1, 1956.
The water completely applied to beneficial use by October 1, 1956.

Witness my hand this 8th day of October, 1956.
Lawrence A. Stanley
(State Engineer)

By _____
(Deputy)

GR-155-C