Township 15S Range 4W, W.M.

North

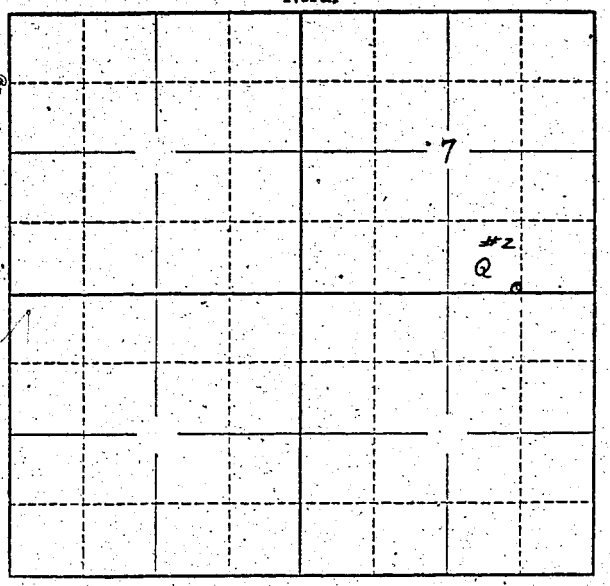

Locate well and acreage of irrigated land on plat.

Scale: 2" = 1 Mile

STATE OF OREGON
County of Lane } ss.

I/We Clarence L. and Edna M. Briggs, being first duly sworn, do hereby certify that I/we have read the foregoing Registration Statement and that all of the items therein contained are true to the best of my/our knowledge and belief.

Clarence L. Briggs
Edna M. Briggs
(Signature of Registrant)

Subscribed and sworn to before me this 22d day of May, 19 58

My commission expires Dec. 15, 1961.

Virginia M Morris
(Notary Public)

(SEAL)

CERTIFICATE OF REGISTRATION

STATE OF OREGON
County of Marion } ss.

This is to certify that the foregoing Registration Statement was received in the office of the State Engineer on the 28th day of May, 1958, at 8:00 o'clock A M. and has been duly recorded in said office in Book No. 7 of Registration Statements on page GR-1578

Witness my hand this 1st day of December, 1958

Lewis A. Stanley
(State Engineer)

$15.30

By
(Deputy)

GR - 1578