


Township 3S Range 1E, W.M.
North

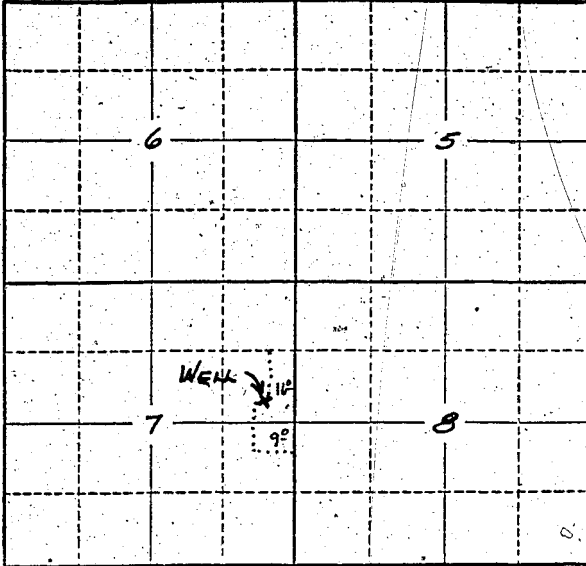

Locate well and acreage of irrigated land on plat.
Scale: 2" = 1 Mile

STATE OF OREGON }
County of Clackamas } ss.

I, Edwin E. Moser, being first duly sworn, do hereby certify that I have read the foregoing Registration Statement and that all of the items therein contained are true to the best of my knowledge and belief.

Edwin E. Moser
(Signature of Registrant)

Subscribed and sworn to before me this 7th day of May, 1958

My commission expires March 27, 1961
[Signature]
(Notary Public)

(SEAL)

CERTIFICATE OF REGISTRATION

STATE OF OREGON }
County of Marion } ss.

This is to certify that the foregoing Registration Statement was received in the office of the State Engineer on the 7th day of May, 1958, at 2:00 o'clock A. M. and has been duly recorded in said office in Book No. 7 of Registration Statements on page GR-1590

Witness my hand this 7th day of January, 1959
[Signature]
(State Engineer)

By _____ (Deputy)

\$15.00