


North

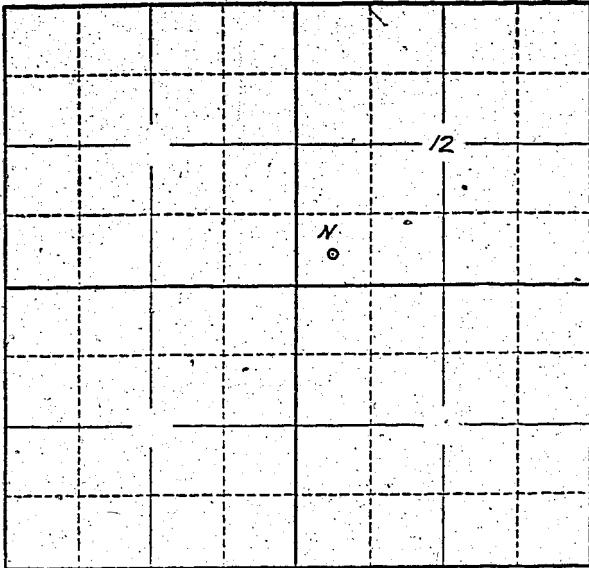

Locate well and acreage of irrigated land on plat.

Scale: 2" = 1 Mile

STATE OF OREGON

County of Linn } ss.

I, Gerald W. and Marie Detering, being first duly sworn, do hereby certify that I have read the foregoing Registration Statement and that all of the items therein contained are true to the best of my knowledge and belief.

Marie Detering & Gerald W. Detering
(Signature of Registrant)

Subscribed and sworn to before me this 31st day of March, 1958.

My commission expires October 4, 1961 Stan A. Tyle
(Notary Public)

(SEAL)

CERTIFICATE OF REGISTRATION

STATE OF OREGON } ss.
County of Marion

This is to certify that the foregoing Registration Statement was received in the office of the State Engineer on the 29th day of May, 1958, at 2:00 o'clock A. M. and has been duly recorded in said office in Book No. 7 of Registration Statements on page GR-1591

Witness my hand this 7th day of January, 1959
Lewis A. Stanley
(State Engineer)

By _____ (Deputy)

#1500