


North

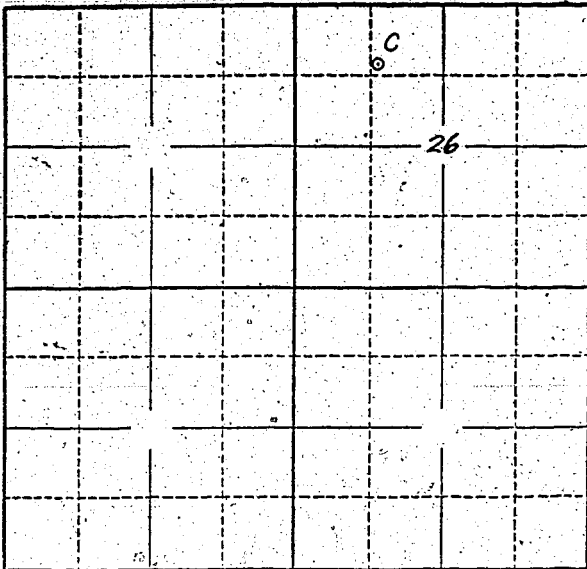

Locate well and acreage of irrigated land on plat.

Scale: 2" = 1 Mile

STATE OF OREGON

County of Linn } ss.

I, Harry M. and Esther S. Dummert, being first duly sworn, do hereby certify that I have read the foregoing Registration Statement and that all of the items therein contained are true to the best of my knowledge and belief.

*Harry M. Dummert*  
*Esther S. Dummert*  
(Signature of Registrant)

Subscribed and sworn to before me this 18 day of April, 1958

My commission expires \_\_\_\_\_  
*W. S. Barber*  
(Notary Public)

(SEAL)

**CERTIFICATE OF REGISTRATION**

STATE OF OREGON } ss.  
County of Marion

This is to certify that the foregoing Registration Statement was received in the office of the State Engineer on the 29<sup>th</sup> day of May, 1958, at 2:00 o'clock A.M. and has been duly recorded in said office in Book No. 7 of Registration Statements on page GR-1595

Witness my hand this 7<sup>th</sup> day of January, 1959  
*Lewis A. Stanley*  
(State Engineer)

By \_\_\_\_\_ (Deputy)

#1500