


567.6 x 1547.7

Acreage involved is rectangular, 567.6 feet by 1547.7 feet.

Sections 1 and 2 Township 137S Range 2 West, W.M.

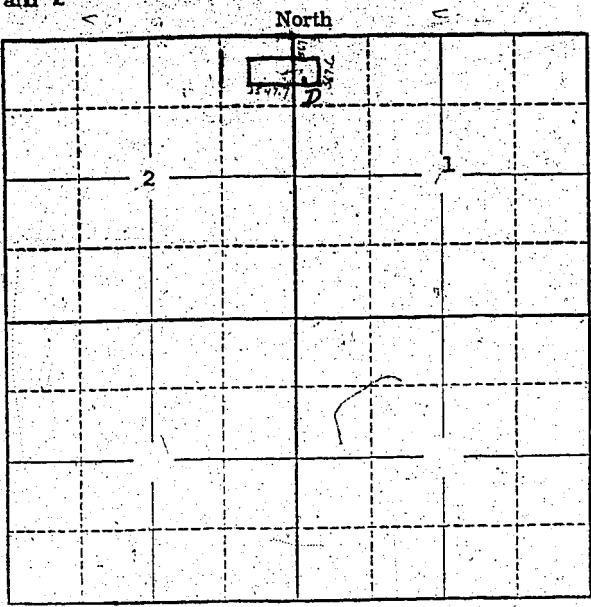

Red dot indicates location of well.

Locate well and acreage of irrigated land on plat. Scale: 2" = 1 Mile

STATE OF OREGON } ss. County of Jackson

I, C. T. Hamilton, being first duly sworn, do hereby certify that I have read the foregoing Registration Statement and that all of the items therein contained are true to the best of my knowledge and belief.

X [Signature] (Signature of Registrant)

Subscribed and sworn to before me this 9 day of July, 1957

My commission expires Nov 28 1966 Walter M. Ferguson (Notary Public)

(SEAL)

CERTIFICATE OF REGISTRATION

STATE OF OREGON } ss. County of Marion

This is to certify that the foregoing Registration Statement was received in the office of the State Engineer on the 29th day of May, 1958, at 2:00 o'clock A.M. and has been duly recorded in said office in Book No. 7 of Registration Statements on page GR-1597

Construction shall be completed by 12 and the water completely applied to beneficial use by 12

Witness my hand this 7th day of January 1959 [Signature] (State Engineer)

\$15.00

By (Deputy) GR-1597