


Township 16S Range 4W, W.M.  
North

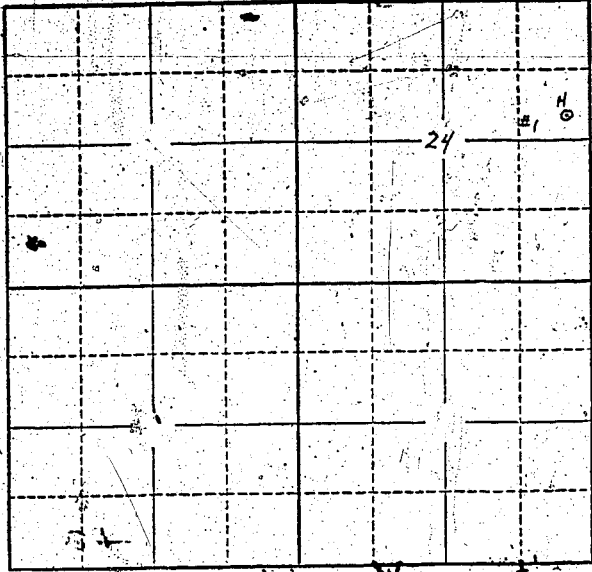

Locate well and acreage of irrigated land on plat.  
Scale: 2" = 1 Mile

STATE OF OREGON

County of Lane } ss.

I, WALTER C. CHASE, being first duly sworn, do hereby certify that I have read the foregoing Registration Statement and that all of the items therein contained are true to the best of my knowledge and belief.

Walter C. Chase  
(Signature of Registrant)

Subscribed and sworn to before me this 14<sup>th</sup> day of March, 1958

My commission expires June 25, 1961 Luella A. Hansen  
(Notary Public)

(SEAL)

**CERTIFICATE OF REGISTRATION**

STATE OF OREGON

County of Marion } ss.

This is to certify that the foregoing Registration Statement, was received in the office of the State Engineer on the 3<sup>rd</sup> day of June, 1958, at 8:00 o'clock A.M. and has been duly recorded in said office in Book No. 7 of Registration Statements on page GR-1603

Witness my hand this 7<sup>th</sup> day of January, 1959

Lewis A. Stanley  
(State Engineer)

By \_\_\_\_\_ (Deputy)

#15.00