


North

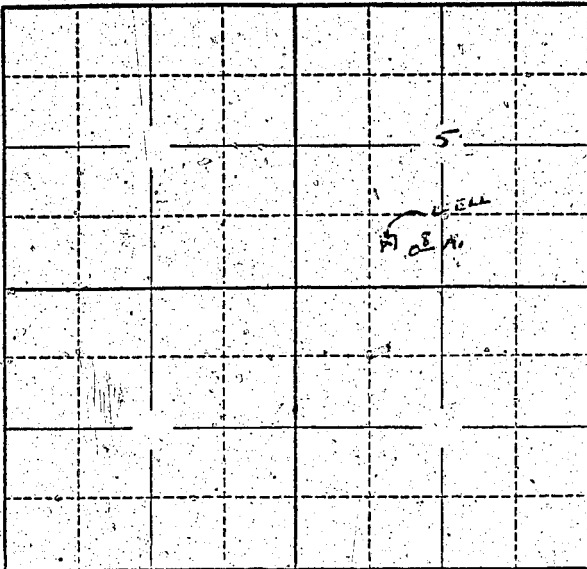

Locate well and acreage of irrigated land on plat.

Scale: 2" = 1 Mile

See attached map - East well

STATE OF OREGON

County of Benton

ss.

I, Chas R. Elliker, being first duly sworn, do hereby certify that I have read the foregoing Registration Statement and that all of the items therein contained are true to the best of my knowledge and belief.

*Chas R. Elliker*

(Signature of Registrant)

Subscribed and sworn to before me this 20th day of June, 1958.

My commission expires Sept. 29, 1961

*Thos J. [unclear]*

(Notary Public)

(SEAL)

CERTIFICATE OF REGISTRATION

STATE OF OREGON

County of Marion

ss.

This is to certify that the foregoing Registration Statement was received in the office of the State Engineer on the 3rd day of June, 1958, at 1:00 o'clock A. M. and has been duly recorded in said office in Book No. 10 of Registration Statements on page GR 2255

Witness my hand this 10th day of March, 1959

*Blair A. [unclear]*

(State Engineer)

By

(Deputy)

#1500