


North

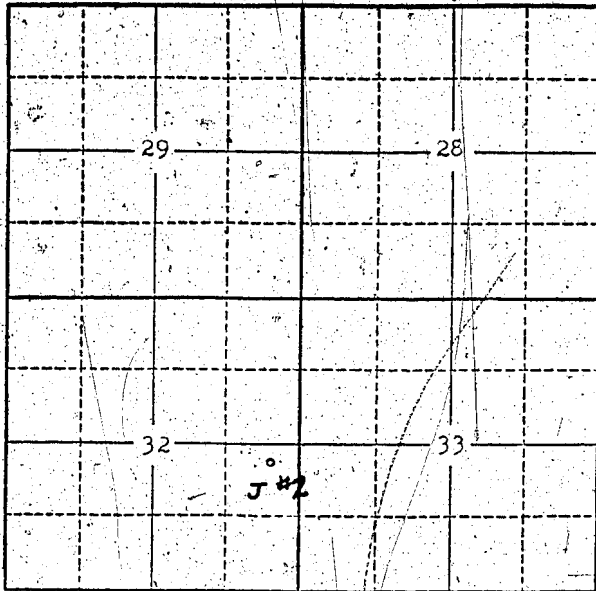

Locate well and acreage of irrigated land on plat.  
Scale: 2" = 1 Mile

STATE OF OREGON

County of Wasco } ss.

I, GEORGE W. McDONALD, PRESIDENT OF CHENWITH IRRIGATION COOPERATIVE, Inc., being first duly sworn, do hereby certify that I have read the foregoing Registration Statement and that all of the items therein contained are true to the best of my knowledge and belief.

Geo. W. McDonald, President  
(Signature of Registrant)

Subscribed and sworn to before me this 22<sup>nd</sup> day of May, 1958

My commission expires January 15, 1962.

David E. Hunter  
(Notary Public)

(SEAL)

**CERTIFICATE OF REGISTRATION**

STATE OF OREGON } ss.  
County of Marion

This is to certify that the foregoing Registration Statement was received in the office of the State Engineer on the 11<sup>th</sup> day of October, 1961, at 8:00 o'clock A. M. and has been duly recorded in said office in Book No. 17 of Registration Statements on page GR-1111

Witness my hand this 30<sup>th</sup> day of October, 1961

Leura A. Stanley  
(State Engineer)

\$ 20.00

By GR-4111 (Deputy)

GR [REDACTED]