


Township 8S Range 4W, W.M.
North

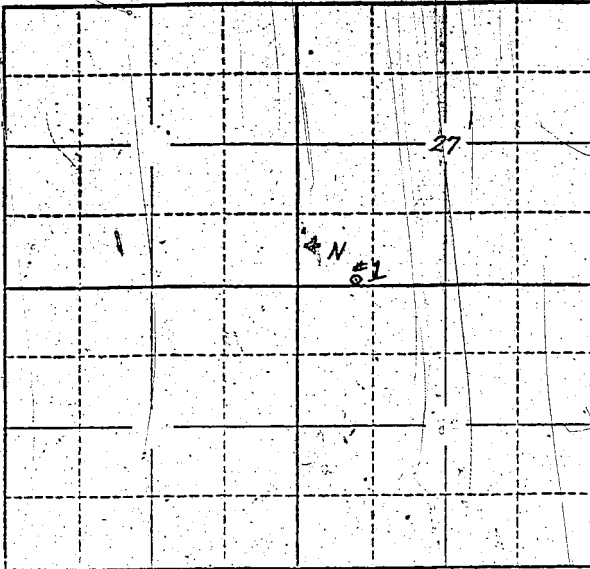

Locate well and acreage of irrigated land on plat.
Scale: 2" = 1 Mile

STATE OF OREGON

County of Marion } ss.

I, B. M. Walker, being first duly sworn, do hereby certify that I have read the foregoing Registration Statement and that all of the items therein contained are true to the best of my knowledge and belief.

[Signature]
(Signature of Registrant)

Subscribed and sworn to before me this 8 day of June, 1958

My commission expires 3-27-58
[Signature]
(Notary Public)

(SEAL)

CERTIFICATE OF REGISTRATION

STATE OF OREGON } ss.
County of Marion

This is to certify that the foregoing Registration Statement was received in the office of the State Engineer on the 3rd day of June, 1958, at 4:20 o'clock P. M. and has been duly recorded in said office in Book No. 8 of Registration Statements on page GR-1761

~~Conservation shall be completed by _____ and the water capacity applied to _____~~

Witness my hand this 7th day of January, 1959

[Signature]
(State Engineer)

By _____
(Deputy)

\$15.00

GR-1761