


Township 8.5 Range 4W W.M. North

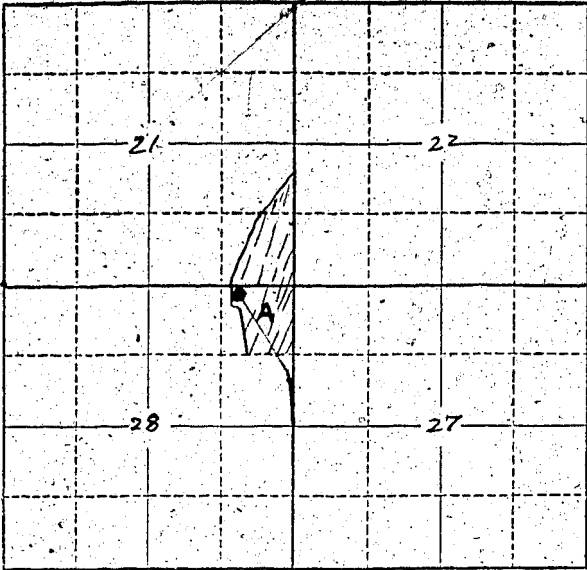

Locate well and acreage of irrigated land on plat.
Scale: 2" = 1 Mile

STATE OF OREGON

County of MARION } ss.

I, OREGON HOP CO - R.M. WALKER being first duly sworn, do hereby certify that I have read the foregoing Registration Statement and that all of the items therein contained are true to the best of my knowledge and belief.

[Handwritten Signature]
(Signature of Registrant)

Subscribed and sworn to before me this 3 day of JUNE, 1958

My commission expires 2-27-62

[Handwritten Signature]
(Notary Public)

(SEAL)

CERTIFICATE OF REGISTRATION

STATE OF OREGON

County of Marion } ss.

This is to certify that the foregoing Registration Statement was received in the office of the State Engineer on the 3rd day of June, 1958, at 4:00 o'clock P.M. and has been duly recorded in said office in Book No. 8 of Registration Statements on page GR-1769

~~Construction shall be completed by 12 o'clock and the water completely applied to the general use by 19~~

Witness my hand this 7th day of January, 1959

[Handwritten Signature]
(State Engineer)

418-45

By _____ (Deputy)

GR-1769