
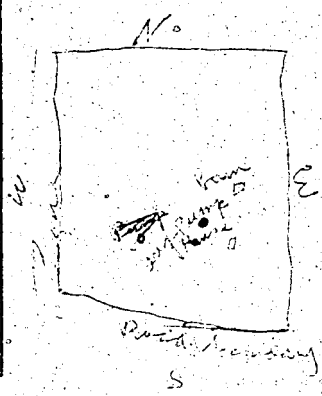


Township 15 Range 4 West, W.M. North

6 5  
7 8

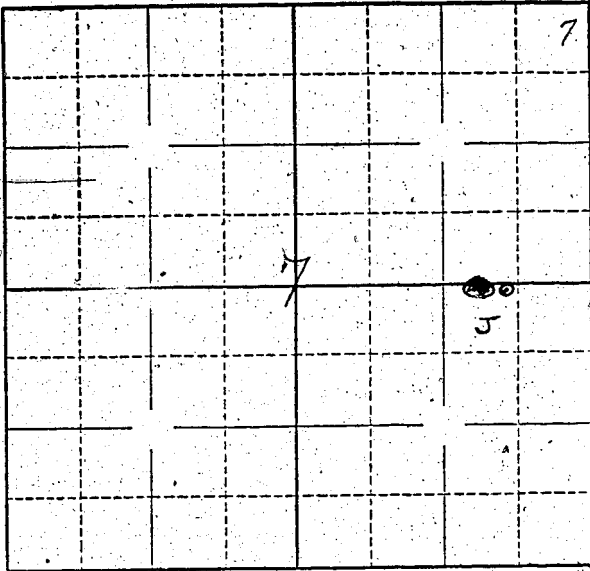

Locate well and acreage of irrigated land on plat.

Scale:  $\frac{1}{4}$ " = 1 Mile

STATE OF OREGON

County of Linn } ss.

I, L. E. Wells, being first duly sworn, do hereby certify that I have read the foregoing Registration Statement and that all of the items therein contained are true to the best of my knowledge and belief.

L. E. Wells  
(Signature of Registrant)

Subscribed and sworn to before me this 3rd day of June, 1958.

My commission expires August 13, 1958

[Signature]  
(Notary Public)

(SEAL)

**CERTIFICATE OF REGISTRATION**

STATE OF OREGON } ss.  
County of Marion

This is to certify that the foregoing Registration Statement was received in the office of the State Engineer on the 4<sup>th</sup> day of June, 1958, at        o'clock        M. and has been duly recorded in said office in Book No. 9 of Registration Statements on page GR-101

Witness my hand this 9<sup>th</sup> day of February, 1959

[Signature]  
(State Engineer)

By         
(Deputy)

\$15.00

GR-101