


Township 2 S Range 1 W W.M.
North Sec 31

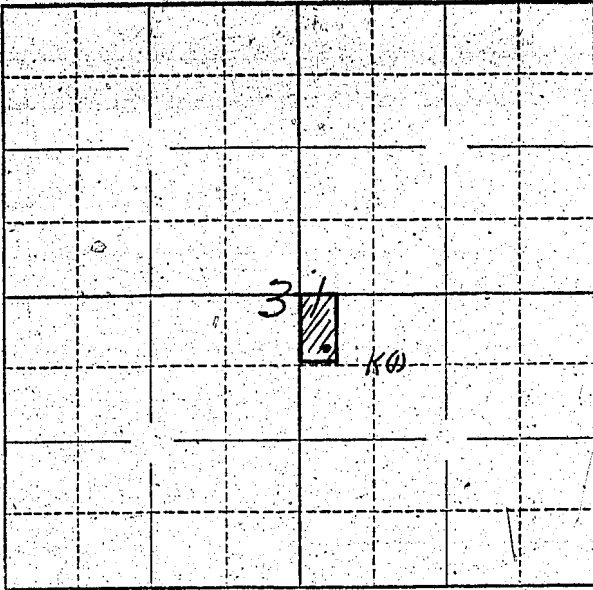

Locate well and acreage of irrigated land on plat.

Scale: $\frac{1}{4}$ " = 1 Mile
 $\frac{1}{8}$ " = 1 "

STATE OF OREGON

County of Washington } ss.

I, Ralph E. Reynolds, being first duly sworn, do hereby certify that I have read the foregoing Registration Statement and that all of the items therein contained are true to the best of my knowledge and belief.

Ralph E Reynolds
(Signature of Registrant)

Subscribed and sworn to before me this 30 day of April, 1957

My commission expires NOTARY PUBLIC IN AND FOR THE STATE OF ORE.
MY COMMISSION EXPIRES NOVEMBER 22, 1957

PS [Signature]
(Notary Public)

(SEAL)

CERTIFICATE OF REGISTRATION

STATE OF OREGON

County of Marion } ss.

This is to certify that the foregoing Registration Statement was received in the office of the State Engineer on the 1st day of May, 1956, at 1:00 o'clock P.M. and has been duly recorded in said office in Book No. 1 of Registration Statements on page GR-159 C

~~Construction shall be completed by _____ and the same shall be completed and recorded by _____~~

Witness my hand this 8th day of October, 1956

Luvis A. Stanley
(State Engineer)

By _____ (Deputy)