


Township 37S Range 1W, W.M.
North

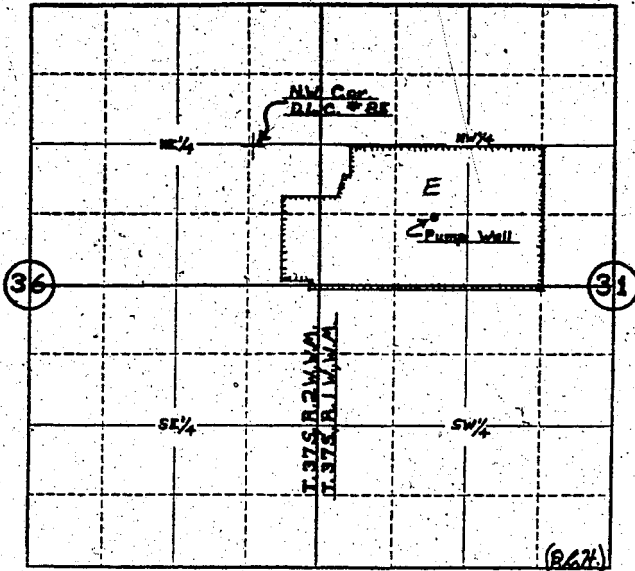

Locate well and acreage of irrigated land on plat.
Scale: 4" = 1 Mile

STATE OF OREGON

County of Jackson

} ss.

I, G. A. Cottingham, being first duly sworn, do hereby certify that I have read the foregoing Registration Statement and that all of the items therein contained are true to the best of my knowledge and belief.

By: G. A. Cottingham
(Signature of Registrant) Secy-Treas.

Subscribed and sworn to before me this 5th day of June, 19 58

NOTARY PUBLIC FOR OREGON

My commission expires My Commission Expires Feb. 8, 1961

G. H. Harrison
(Notary Public)

(SEAL)

CERTIFICATE OF REGISTRATION

STATE OF OREGON

County of Marion

} ss.

This is to certify that the foregoing Registration Statement was received in the office of the State Engineer on the 9th day of June, 19 58, at 2:00 o'clock A.M. and has been duly recorded in said office in Book No. 8 of Registration Statements on page GR-1632

Witness my hand this 7th day of January, 19 59

Lewis J. Stanley
(State Engineer)

By _____
(Deputy)

\$ 20.00