


North

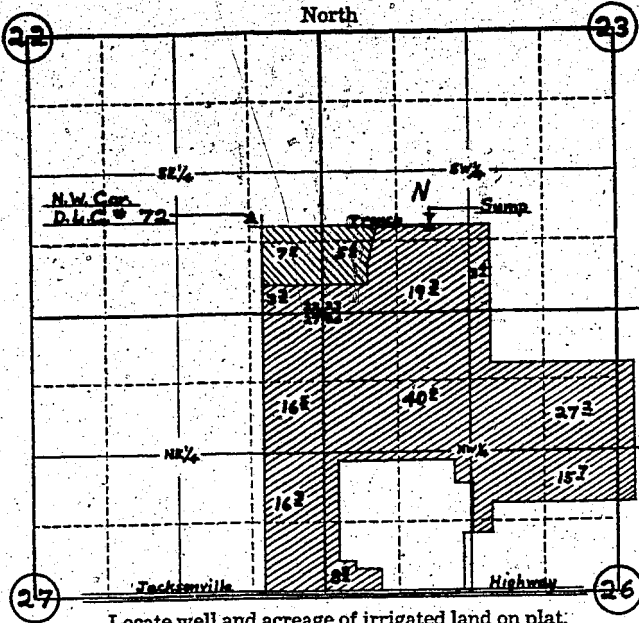

Locate well and acreage of irrigated land on plat:

Scale: 4" = 1 Mile (P.L.A.)

STATE OF OREGON

County of Jackson } ss.

I, G. A. Cottingham, being first duly sworn, do hereby certify that I have read the foregoing Registration Statement and that all of the items therein contained are true to the best of my knowledge and belief.

By: [Signature] Secy-Treas. (Signature of Registrant)

Subscribed and sworn to before me this 5th day of June, 1958

NOTARY PUBLIC FOR OREGON

My commission expires My Commission Expires Feb. 8, 1961

[Signature] (Notary Public)

(SEAL)

CERTIFICATE OF REGISTRATION

STATE OF OREGON

County of Marion } ss.

This is to certify that the foregoing Registration Statement was received in the office of the State Engineer on the 7th day of June, 1958, at 8:00 o'clock A.M. and has been duly recorded in said office in Book No. 8 of Registration Statements on page GR-1633

Witness my hand this 7th day of January, 1959

[Signature] (State Engineer)

By (Deputy)

\$ 28.00

GR-1633