


Township 2S Range 3E W.M. North

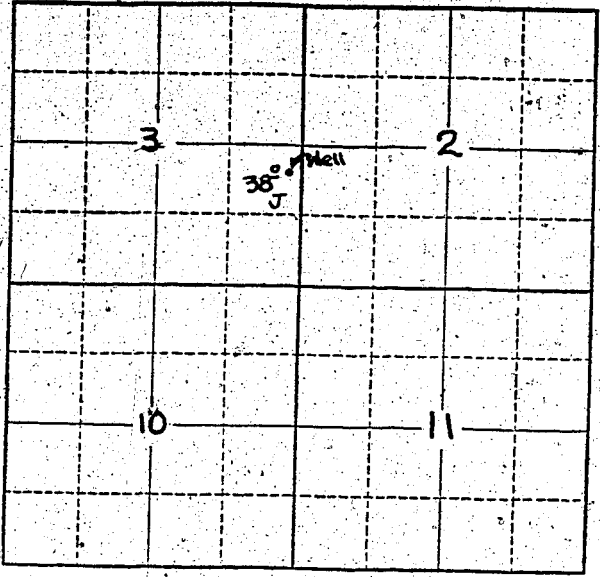

Locate well and acreage of irrigated land on plat.
Scale: 2" = 1 Mile

STATE OF OREGON


I, WALTER STUBERT, being first duly sworn, do hereby certify that I have read the foregoing Registration Statement and that all of the items therein contained are true to the best of my knowledge and belief.

Walter Stubert
(Signature of Registrant)

Subscribed and sworn to before me this 8th day of APRIL, 1958.

My commission expires My Commission Expires April 19, 1961

Walter Sheedy
(Notary Public)

(SEAL)

CERTIFICATE OF REGISTRATION

STATE OF OREGON }
County of Marion } ss.

This is to certify that the foregoing Registration Statement was received in the office of the State Engineer on the 9th day of June, 1958, at 8:00 o'clock A. M. and has been duly recorded in said office in Book No. 8 of Registration Statements on page GR-1634

Witness my hand this 7th day of January, 1959

Lewis A. Stanley
(State Engineer)

By _____
(Deputy)

#16-20