


North

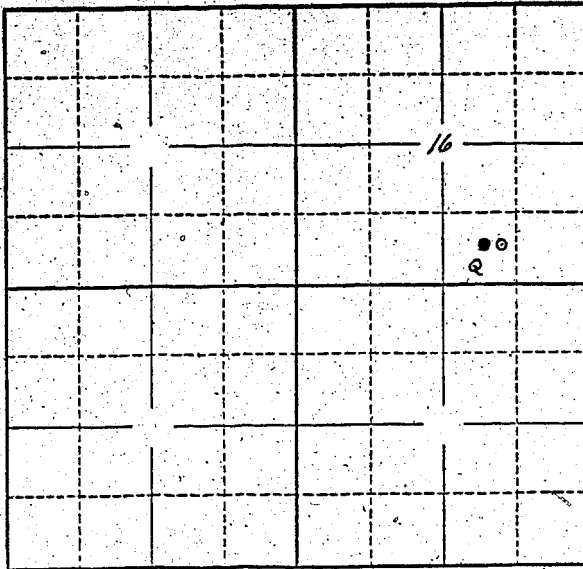

Locate well and acreage of irrigated land on plat.

Scale: 2" = 1 Mile

STATE OF OREGON

County of LINN

ss.

I, J. H. Lyon, being first duly sworn, do hereby certify that I have read the foregoing Registration Statement and that all of the items therein contained are true to the best of my knowledge and belief.

*J. H. Lyon*  
(Signature of Registrant)

Subscribed and sworn to before me this 9 day of June, 1952

My commission expires

*Marion A. Hutchings*  
(Notary Public)  
Justice of the Peace  
Jefferson Dist. County of Marion  
Jefferson Co.

(SEAL)

CERTIFICATE OF REGISTRATION

STATE OF OREGON

County of Marion

ss.

This is to certify that the foregoing Registration Statement was received in the office of the State Engineer on the 11th day of June, 1952, at 8:00 o'clock A.M. and has been duly recorded in said office in Book No. 8 of Registration Statements on page GR-1652

Witness my hand this 7th day of January, 1959

*Lucas A. Stanley*  
(State Engineer)

\$1500

By \_\_\_\_\_ (Deputy)