Township 38S Range 1W, W.M.

North

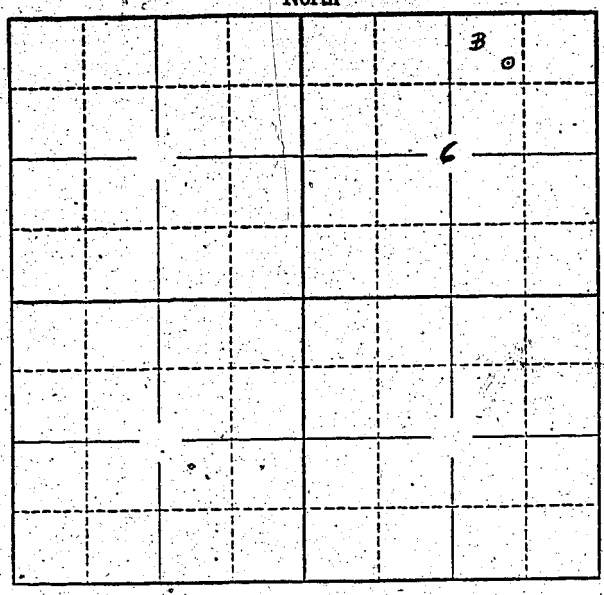

Locate well and acreage of irrigated land on plat.

Scale: 2" = 1 Mile

STATE OF OREGON
County of Jackson } ss.

I, G. A. Cottingham, being first duly sworn, do hereby certify that I have read the foregoing Registration Statement and that all of the items therein contained are true to the best of my knowledge and belief.

HARRY and DAVID

By: G. A. Cottingham Secy-Treas.
(Signature of Registrant)

Subscribed and sworn to before me this 6th day of June, 19 58

My commission expires NOTARY PUBLIC FOR OREGON
My Commission Expires Feb. 8, 1961

G. W. Hanson
(Notary Public)

(SEAL)

CERTIFICATE OF REGISTRATION

STATE OF OREGON
County of Marion } ss.

This is to certify that the foregoing Registration Statement was received in the office of the State Engineer on the 12th day of June, 1958 at 8:00 o'clock A M. and has been duly recorded in said office in Book No. 8 of Registration Statements on page GR-1660

Witness my hand this 7th day of January, 1959.

Lewis A. Stanley
(State Engineer)

By
(Deputy)

$20.00

GR-1660