


North

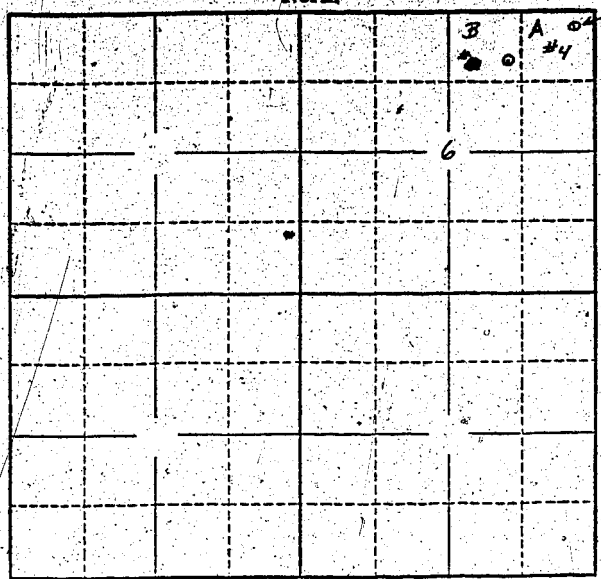

Locate well and acreage of irrigated land on plat.
Scale: 2" = 1 Mile

STATE OF OREGON

County of Jackson } ss.

I, G. A. Cottingham, being first duly sworn, do hereby certify that I have read the foregoing Registration Statement and that all of the items therein contained are true to the best of my knowledge and belief.

HARRY and DAVID
By: G. A. Cottingham Secy-Treas.
(Signature of Registrant)

Subscribed and sworn to before me this 6th day of June, 1958

My commission expires _____

G. W. Hanna
(Notary Public)

(SEAL) NOTARY PUBLIC FOR OREGON
My Commission Expires Feb. 8, 1961

CERTIFICATE OF REGISTRATION

STATE OF OREGON } ss.
County of Marion

This is to certify that the foregoing Registration Statement was received in the office of the State Engineer on the 12th day of June, 1958, at 2:00 o'clock A.M. and has been duly recorded in said office in Book No. 8 of Registration Statements on page GR-1661

Witness my hand this 7th day of January, 1959

Leora A. Stanley
(State Engineer)

By _____ (Deputy)

20.00