


North

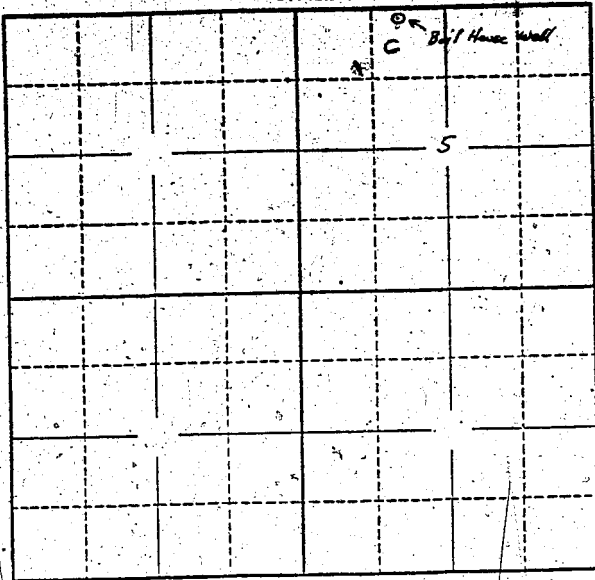

Locate well and acreage of irrigated land on plat.

Scale: 2" = 1 Mile

STATE OF OREGON }
County of Jackson } ss.

I, G. A. Cottingham, being first duly sworn, do hereby certify that I have read the foregoing Registration Statement and that all of the items therein contained are true to the best of my knowledge and belief. HARRY and DAVID

By: [Signature] Secy-Treas.
(Signature of Registrant)

Subscribed and sworn to before me this 6th day of June, 19 58

My commission expires NOTARY PUBLIC FOR OREGON
My Commission Expires Feb. 8, 1961
(SEAL)

[Signature]
(Notary Public)

CERTIFICATE OF REGISTRATION

STATE OF OREGON }
County of Marion } ss.

This is to certify that the foregoing Registration Statement was received in the office of the State Engineer on the 12th day of June, 1958, at 5:00 o'clock A. M. and has been duly recorded in said office in Book No. 8 of Registration Statements on page GR-1662

Witness my hand this 7th day of January

[Signature] 19 59
(State Engineer)

By _____
(Deputy)

\$20.00