


Township 38 S Range 1 W W.M.  
North

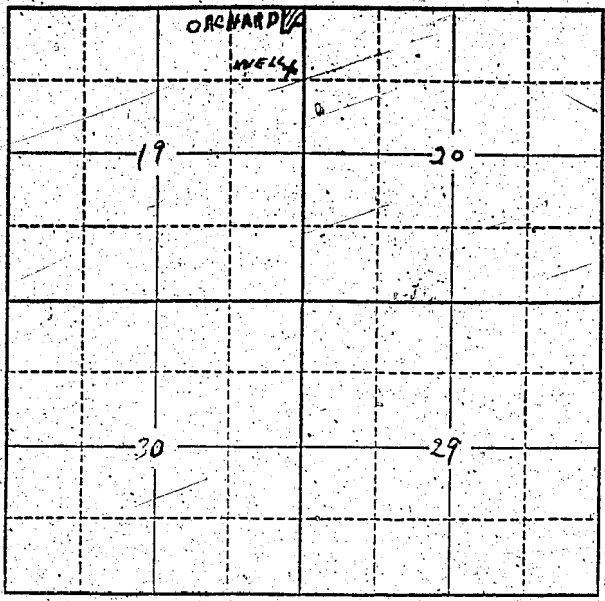

Locate well and acreage of irrigated land on plat.  
Scale: 2" = 1 Mile

STATE OF OREGON }  
County of JACKSON } ss.

I, LESTER LEE IGO, being first duly sworn, do hereby certify that I have read the foregoing Registration Statement and that all of the items therein contained are true to the best of my knowledge and belief.

Lester Lee Igo  
(Signature of Registrant)

Subscribed and sworn to before me this 4th day of May, 1956.

My commission expires 12-16-58

Thomas A. Banks  
(Notary Public)

(SEAL)

**CERTIFICATE OF REGISTRATION**

STATE OF OREGON }  
County of Marion } ss.

This is to certify that the foregoing Registration Statement was received in the office of the State Engineer on the 7th day of May, 1956, at 8 o'clock A. M. and has been duly recorded in said office in Book No. 1 of Registration Statements on page GR-163 C

~~Completion shall be completed by \_\_\_\_\_ of the \_\_\_\_\_ State of \_\_\_\_\_ applied to \_\_\_\_\_~~

Witness my hand this 8th day of October

Lewis A. Stanley  
(State Engineer)

By \_\_\_\_\_  
(Deputy)