


NW Corner Charles  
Mulkey DLC #69

S 89° 38' E

9.55 ch

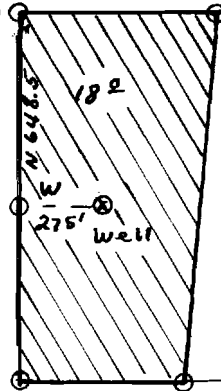

SE  $\frac{1}{4}$  NE  $\frac{1}{4}$

Robert E. Taylor  
Rt. 4, Box 351, Corvallis, Oreg.  
Sec 36, T11S, R5W, W.M.  
Scale 1" = 660', June, 1958

|    |    |
|----|----|
| 36 | 31 |
| 1  | 6  |