


Township 6N Range 35E, W.M.  
North

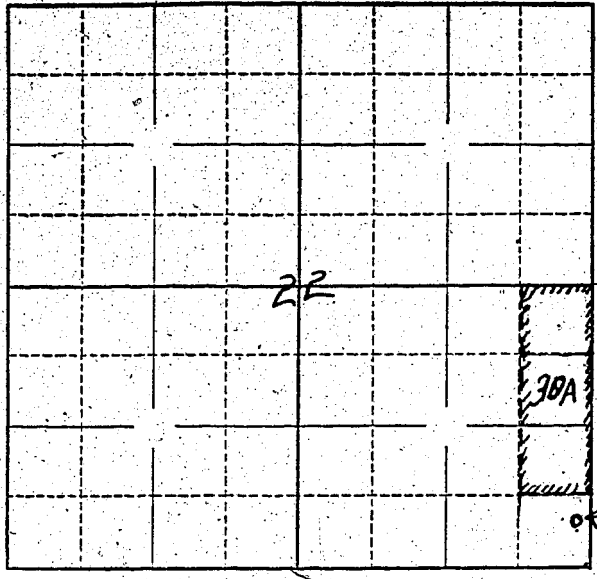

Well Location  
440 feet N  
12 feet West of  
S.E. Corner Sec

Locate well and acreage of irrigated land on plat.  
Scale: 1/4 - 1 Mile

STATE OF OREGON  
County of Umatilla ss.

I, Frank L. Parent, being first duly sworn, do hereby certify that I have read the foregoing Registration Statement and that all of the items therein contained are true to the best of my knowledge and belief.

Frank L. Parent  
(Signature of Registrant)

Subscribed and sworn to before me this 11th day of November, 1958.

My commission expires Sept. 8, 1960

[Signature]  
(Notary Public)

(SEAL)

### CERTIFICATE OF REGISTRATION

STATE OF OREGON }  
County of Marion } ss.

This is to certify that the foregoing Registration Statement was received in the office of the State Engineer on the 13th day of June, 1958, at 1:00 o'clock P. M. and has been duly recorded in said office in Book No. 8 of Registration Statements on page GR-1678

Witness my hand this 7th day of January, 1959.

[Signature]  
(State Engineer)

By \_\_\_\_\_ (Deputy)

GR-1678

1/500