


Township 1N Range 3W W.M.  
North

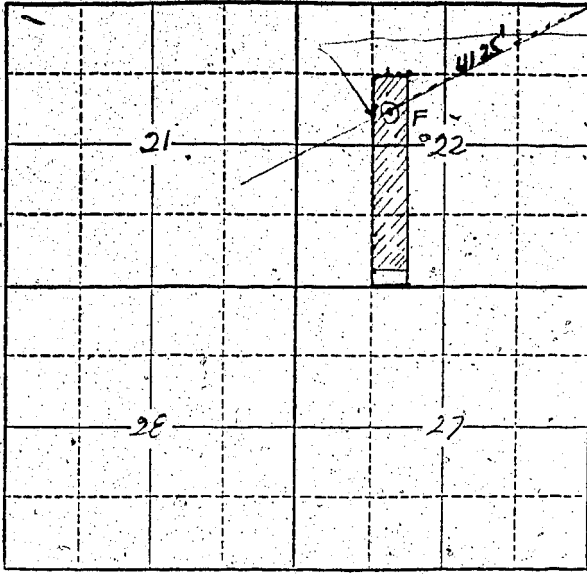

Well

Locate well and acreage of irrigated land on plat.  
Scale: 2" = 1 Mile

STATE OF OREGON

County of \_\_\_\_\_ } ss.

I, \_\_\_\_\_, being first duly sworn, do hereby certify that I have read the foregoing Registration Statement and that all of the items therein contained are true to the best of my knowledge and belief.

*Jack Delplanche*  
(Signature of Registrant)

Subscribed and sworn to before me this 17 day of June, 1958

My commission expires Sept. 24, 1958 *Flora B. Shoup*  
(Notary Public)

(SEAL)

NOTARY PUBLIC FOR OREGON  
My Commission Expires Sept. 24, 1958

**CERTIFICATE OF REGISTRATION**

STATE OF OREGON

County of Marion } ss.

This is to certify that the foregoing Registration Statement was received in the office of the State Engineer on the 16<sup>th</sup> day of June, 1958, at 8:00 o'clock A. M. and has been duly recorded in said office in Book No. 8 of Registration Statements on page GR-1679

~~Construction shall be completed by \_\_\_\_\_ 19\_\_\_\_ and the water completely applied to beneficial use by \_\_\_\_\_ 19\_\_\_\_~~

Witness my hand this 7<sup>th</sup> day of January, 1959

*Levo A. Ottavio*  
(State Engineer)

By \_\_\_\_\_ (Deputy)

GR-1679

\$18.00