


Section 33 T. 15 R. 3E

Township 15 Range 3E W.M.
North

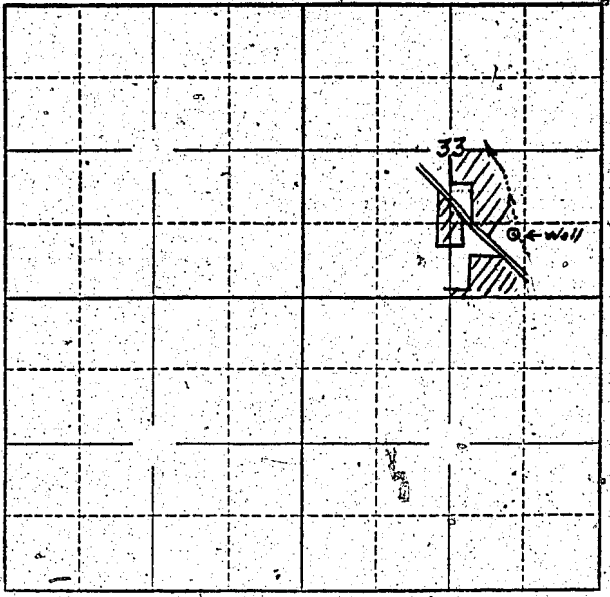

Locate well and acreage of irrigated land on plat.

Scale: 2" = 1 Mile

STATE OF OREGON

County of Clackamas } SS.

I, Odin D. Manser, being first duly sworn, do hereby certify that I have read the foregoing Registration Statement and that all of the items therein contained are true to the best of my knowledge and belief.

Odin D. Manser
(Signature of Registrant)

Subscribed and sworn to before me this 6th day of February, 1956.

My commission expires March 27, 1957

[Signature]
(Notary Public)

(SEAL)

CERTIFICATE OF REGISTRATION

STATE OF OREGON

County of Marion } SS.

This is to certify that the foregoing Registration Statement was received in the office of the State Engineer on the 20th day of March, 1956, at 8 o'clock A. M. and has been duly recorded in said office in Book No. 1 of Registration Statements on page GR-164 C.

~~Registration Statement to be recorded by _____, and the rates completely applied to _____~~

Witness my hand this 8th day of October, 1956.

Lewis A. Stanley
(State Engineer)

By _____
(Deputy)

GR-164 C