


Township 7S Range 2W W.M.  
North

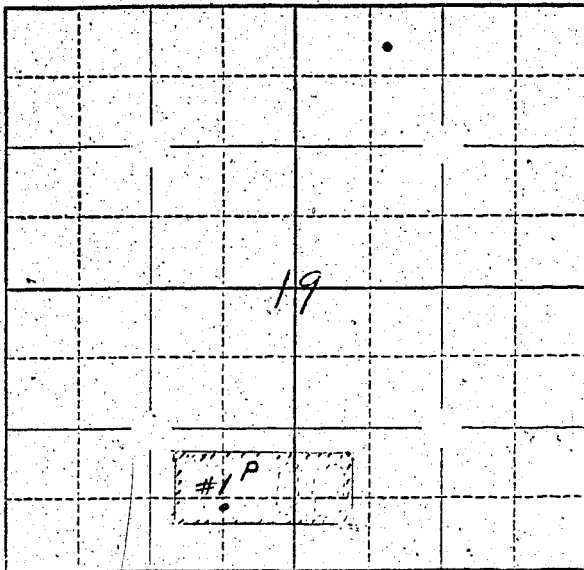

Locate well and acreage of irrigated land on plat.

Scale:  $\frac{1}{4}$ " = 1 Mile  
 $4" = 1$  Mile

STATE OF OREGON

County of Marion } ss.

I, Rafael Antonio de Peralta being first duly sworn, do hereby certify that I have read the foregoing Registration Statement and that all of the items therein contained are true to the best of my knowledge and belief.

Rafael Antonio de Peralta  
(Signature of Registrant)

Subscribed and sworn to before me this 3 day of April, 1958.

My commission expires July 27, 1958

Louis W. Amert  
(Notary Public)

(SEAL)

**CERTIFICATE OF REGISTRATION**

STATE OF OREGON

County of Marion } ss.

This is to certify that the foregoing Registration Statement was received in the office of the State Engineer on the 16th day of June, 1958, at 5:00 o'clock A.M. and has been duly recorded in said office in Book No. 8 of Registration Statements on page GR-1687.

~~Construction shall be completed by \_\_\_\_\_, 19\_\_\_\_ and the water completely applied to beneficial use by \_\_\_\_\_, 19\_\_\_\_.~~

Witness my hand this 7th day of January, 1959.

Leura A. Stanley  
(State Engineer)

By \_\_\_\_\_ (Deputy)

\$ 25.00

GR-1687