


Township 9S Range 1W, W.M.
North

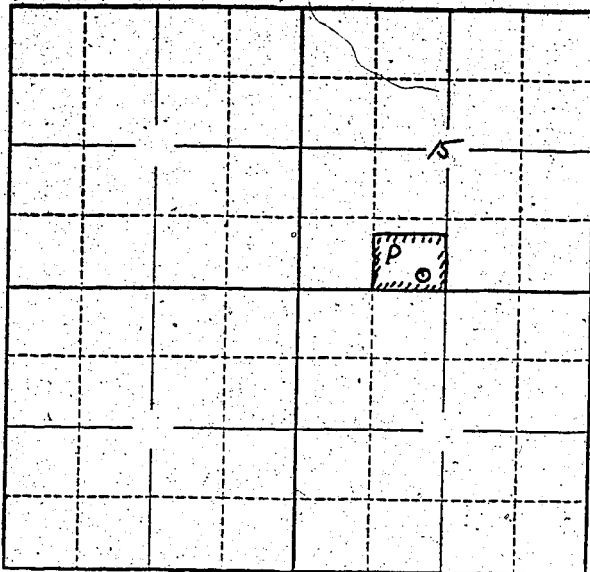

Locate well and acreage of irrigated land on plat.

Scale: 2" = 1 Mile

STATE OF OREGON

County of Marion

SS.

I, Edd Hobson, being first duly sworn, do hereby certify that I have read the foregoing Registration Statement and that all of the items therein contained are true to the best of my knowledge and belief.

Edd Hobson
(Signature of Registrant)

Subscribed and sworn to before me this 19th day of June, 1958

My commission expires 12th June 1961

Wm. S. Bartholomew
(Notary Public)

(SEAL)

CERTIFICATE OF REGISTRATION

STATE OF OREGON

County of Marion

SS.

This is to certify that the foregoing Registration Statement was received in the office of the State Engineer on the 19th day of June, 1958, at 12⁰⁰ o'clock A M. and has been duly recorded in said office in Book No. 8 of Registration Statements on page GR-1697

Witness my hand this 7th day of January, 1959

Laura A. Stanley
(State Engineer)

By _____

(Deputy)

GR-1697