


Township 6S Range 2W, W.M.  
North

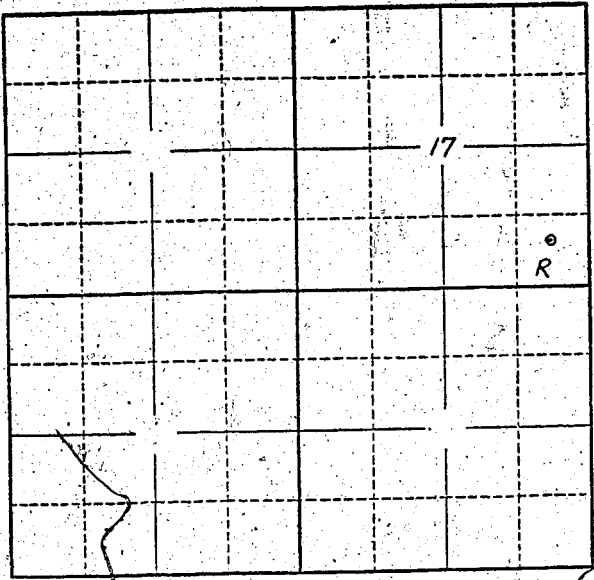

Locate well and acreage of irrigated land on plat.  
Scale: 2" = 1 Mile

STATE OF OREGON }  
County of Marion } ss.

I, Mrs. Ruth D. Morrison, being first duly sworn, do hereby certify that I have read the foregoing Registration Statement and that all of the items therein contained are true to the best of my knowledge and belief.

Ruth D Morrison  
(Signature of Registrant)

Subscribed and sworn to before me this 20th day of June, 1958

My commission expires 12th June 1961 Wm. S. Bartholomew  
(Notary Public)

(SEAL)

**CERTIFICATE OF REGISTRATION**

STATE OF OREGON }  
County of Marion } ss.

This is to certify that the foregoing Registration Statement was received in the office of the State Engineer on the 20th day of June, 1958, at 9:00 o'clock A.M. and has been duly recorded in said office in Book No. 8 of Registration Statements on page GR-1705

Witness my hand this 7th day of January, 1959  
Lewis A. Stanley  
(State Engineer)

By \_\_\_\_\_ (Deputy)

\$1,500

GR-1705