


North

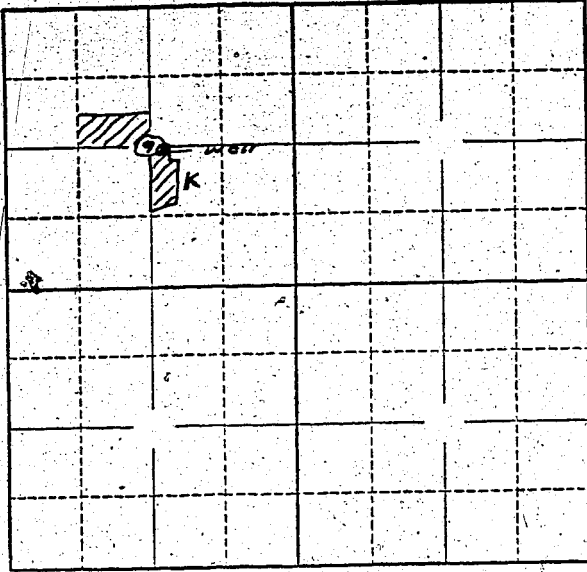

Locate well and acreage of irrigated land on plat.

Scale: 2" = 1 Mile

STATE OF OREGON

County of Lane } ss.

I, Leland C Ross, being first duly sworn, do hereby certify that I have read the foregoing Registration Statement and that all of the items therein contained are true to the best of my knowledge and belief.

Leland C Ross  
(Signature of Registrant)

Subscribed and sworn to before me this 7th day of June 1958.

NOTARY PUBLIC FOR OREGON.

My commission expires My Commission Expires Oct. 16, 1959

Robert R. Irwin  
(Notary Public)

(SEAL)

**CERTIFICATE OF REGISTRATION**

STATE OF OREGON } ss.  
County of Marion

This is to certify that the foregoing Registration Statement was received in the office of the State Engineer on the 23rd day of June, 1958, at 8:00 o'clock A. M. and has been duly recorded in said office in Book No. 8 of Registration Statements on page GR-1711

Witness my hand this 7th day of January 1959

Lewis A. Stanley  
(State Engineer)

By \_\_\_\_\_ (Deputy)

15.60