


North

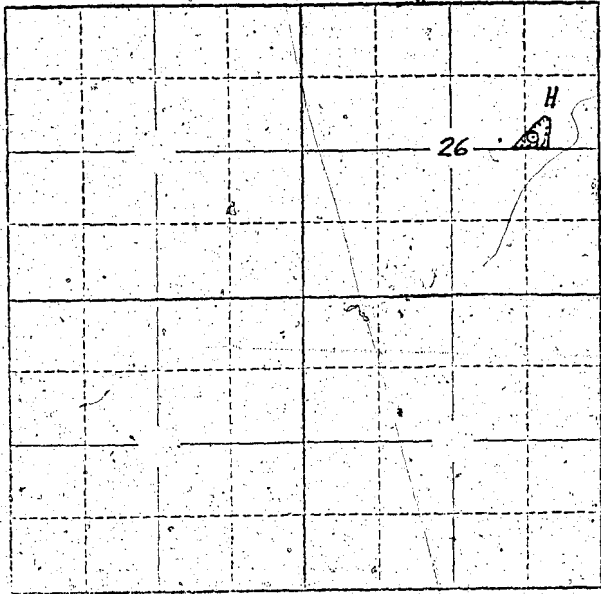

Locate well and acreage of irrigated land on plat.
Scale: 2" = 1 Mile

STATE OF OREGON

County of Clatsop } ss.

I, John G. Lamb, being first duly sworn, do hereby certify that I have read the foregoing Registration Statement and that all of the items therein contained are true to the best of my knowledge and belief.

John G. Lamb
(Signature of Registrant)

Subscribed and sworn to before me this 19th day of June, 1959

My commission expires June 30 - 1961 June H. Bil
(Notary Public)

(SEAL)

CERTIFICATE OF REGISTRATION

STATE OF OREGON

County of Marion } ss.

This is to certify that the foregoing Registration Statement was received in the office of the State Engineer on the 23rd day of June, 1959, at 8:00 o'clock A. M. and has been duly recorded in said office in Book No. 16 of Registration Statements on page GR 3804

~~XX Conditions shall be completed by [unclear] and the water completely applied on [unclear] by [unclear] XX~~

Witness my hand this 4th day of December, 1959

W. A. Stanley
(State Engineer)

By _____ (Deputy)

\$15.00