


Township 1S Range 3E W.M.

SE 5TH ST North 1N 3E

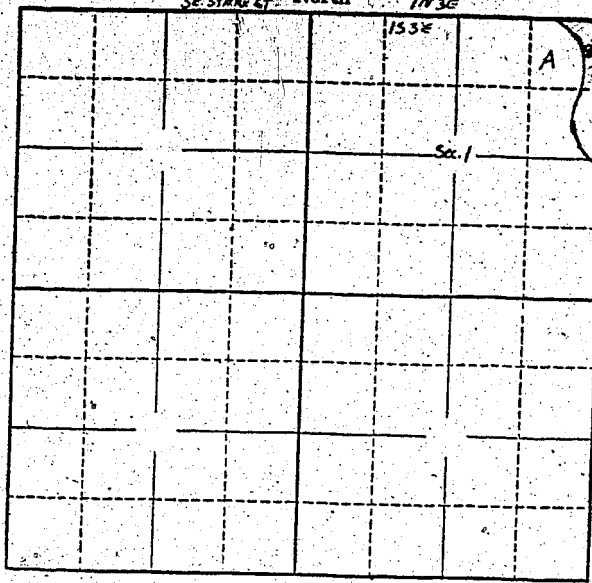

Locate well and acreage of irrigated land on plat.

Scale: 2" = 1 Mile

STATE OF OREGON

County of _____ } ss.

I, W. P. Nuffer, being first duly sworn, do hereby certify that I have read the foregoing Registration Statement and that all of the items therein contained are true to the best of my knowledge and belief.

Mountain View Tractor, Inc.
W. P. Nuffer (Secretary)
(Signature of Registrant)

Subscribed and sworn to before me this 19th day of June, 1958.

My commission expires 10-10-59

Jane
Mildred Belt
(Notary Public)

(SEAL)

CERTIFICATE OF REGISTRATION

STATE OF OREGON }
County of Marion } ss.

This is to certify that the foregoing Registration Statement was received in the office of the State Engineer on the 23rd day of June, 1958, at 8:00 o'clock A. M. and has been duly recorded in said office in Book No. 8 of Registration Statements on page GR-1712

Witness my hand this 7th day of January, 1959

\$15.00

Leuro A. Stanley
(State Engineer)

By _____ (Deputy)