


North

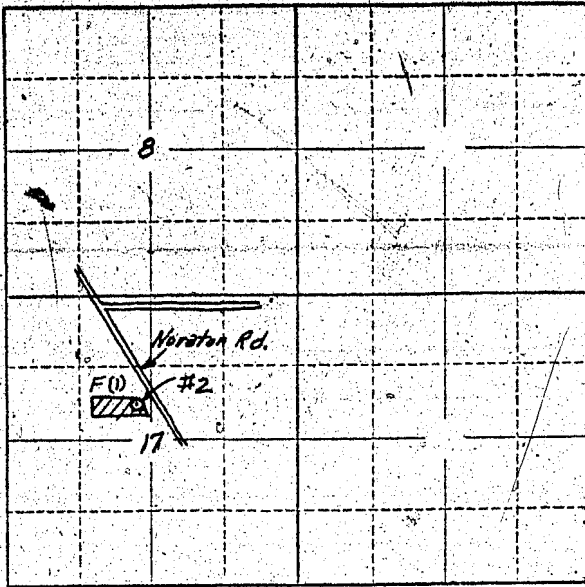

Locate well and acreage of irrigated land on plat.

Scale: 2" = 1 Mile

STATE OF OREGON

County of Linn

ss.

I, Roy C. Betterton, being first duly sworn, do hereby certify that I have read the foregoing Registration Statement and that all of the items therein contained are true to the best of my knowledge and belief.

Roy C. Betterton

(Signature of Registrant)

Subscribed and sworn to before me this 8th day of May, 1956.

My commission expires August 13, 1958

Wm. W. Lee
(Notary Public)
Notary Public for Oregon

(SEAL)

CERTIFICATE OF REGISTRATION

STATE OF OREGON

County of Marion

ss.

This is to certify that the foregoing Registration Statement was received in the office of the State Engineer on the 9th day of May, 1956 at 8:00 o'clock A. M. and has been duly recorded in said office in Book No. 2 of Registration Statements on page GR-313 C.

~~Construction shall be completed on or before May 10, 1956 and the water right shall be~~

~~beneficially used by May 10, 1956~~

Witness my hand this 1st day of April, 1957

Lewis A. Stanley
(State Engineer)

By

(Deputy)

\$15.00