


Township 11 S Range 4 W, W.M.
North

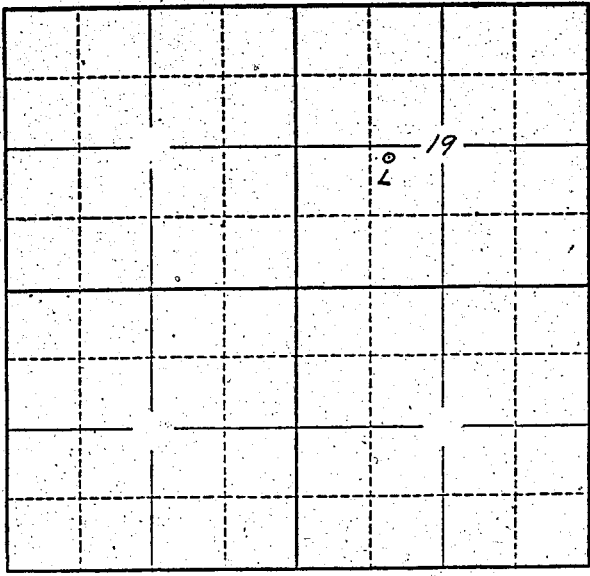

Locate well and acreage of irrigated land on plat.
Scale: 2" = 1 Mile

STATE OF OREGON }
County of Benton } ss.

I, Edmond K. Vanhook, being first duly sworn, do hereby certify that I have read the foregoing Registration Statement and that all of the items therein contained are true to the best of my knowledge and belief.

Edmond K. Vanhook
(Signature of Registrant)

Subscribed and sworn to before me this 20 day of June, 1958

My commission expires NOTARY PUBLIC FOR OREGON
MY COMMISSION EXPIRES NOV. 16, 1961

Gayle Schumacher
(Notary Public)

(SEAL)

CERTIFICATE OF REGISTRATION

STATE OF OREGON }
County of Marion } ss.

This is to certify that the foregoing Registration Statement was received in the office of the State Engineer on the 23rd day of June, 1958, at 9.00 o'clock A. M. and has been duly recorded in said office in Book No. 8 of Registration Statements on page GR-1716

Witness my hand this 7th day of January, 1959

Lewis A. Stanley
(State Engineer)

By _____
(Deputy)

\$15.00